



APPLICATION FOR A MODIFICATION ORDER

WILDLIFE AND COUNTRYSIDE ACT 1981
NOTTINGHAMSHIRE DEFINITIVE MAP AND STATEMENT

To: NOTTINGHAMSHIRE COUNTY COUNCIL
RIGHTS OF WAY SECTION
ENVIRONMENT DEPARTMENT
TRENT BRIDGE HOUSE
FOX ROAD
WEST BRIDGFORD
NOTTINGHAM NG2 6BJ

CHRISTOPHER THOMPSON, RAMBLERS

I/We, ASSOCIATION (NOTTS AREA) of 21 SPINDLE VIEW, CALVERTON, NOTTS
NG14 6HF

hereby apply for an order under Section 53(2) of the Wildlife and Countryside Act 1981 modifying the Nottinghamshire Definitive Map and Statement for the District of Newark and Sherwood by

*1. ~~deleting the route known as _____ and running from _____~~

to _____

*2. Adding the (footpath) (~~bridleway~~) (~~byway open to all traffic~~) situated in the Parish/Town of BLEASBY and running from HIGH CROSS SK 699507 to SOUTHWELL ROAD SK 698506

*3. (~~upgrading~~) (~~downgrading~~) to a (footpath) (~~bridleway~~) (~~byway open to all traffic~~) the route known as _____ and running from _____ to _____

*4. (~~varying~~) (~~adding to~~) the particulars relating to the route known as _____ and running from _____

to _____

by _____

and shown on the map annexed hereto.


* Please complete the appropriate section.

I/We attach copies and list below the following documentary evidence (including statements of witness(es)) in support of this application.

DOCUMENTS

FINANCE ACT MAP | VALUATION BOOK
DEFINITIVE MAP BASE MAP

Dated 1st Oct 2010 Signed _____

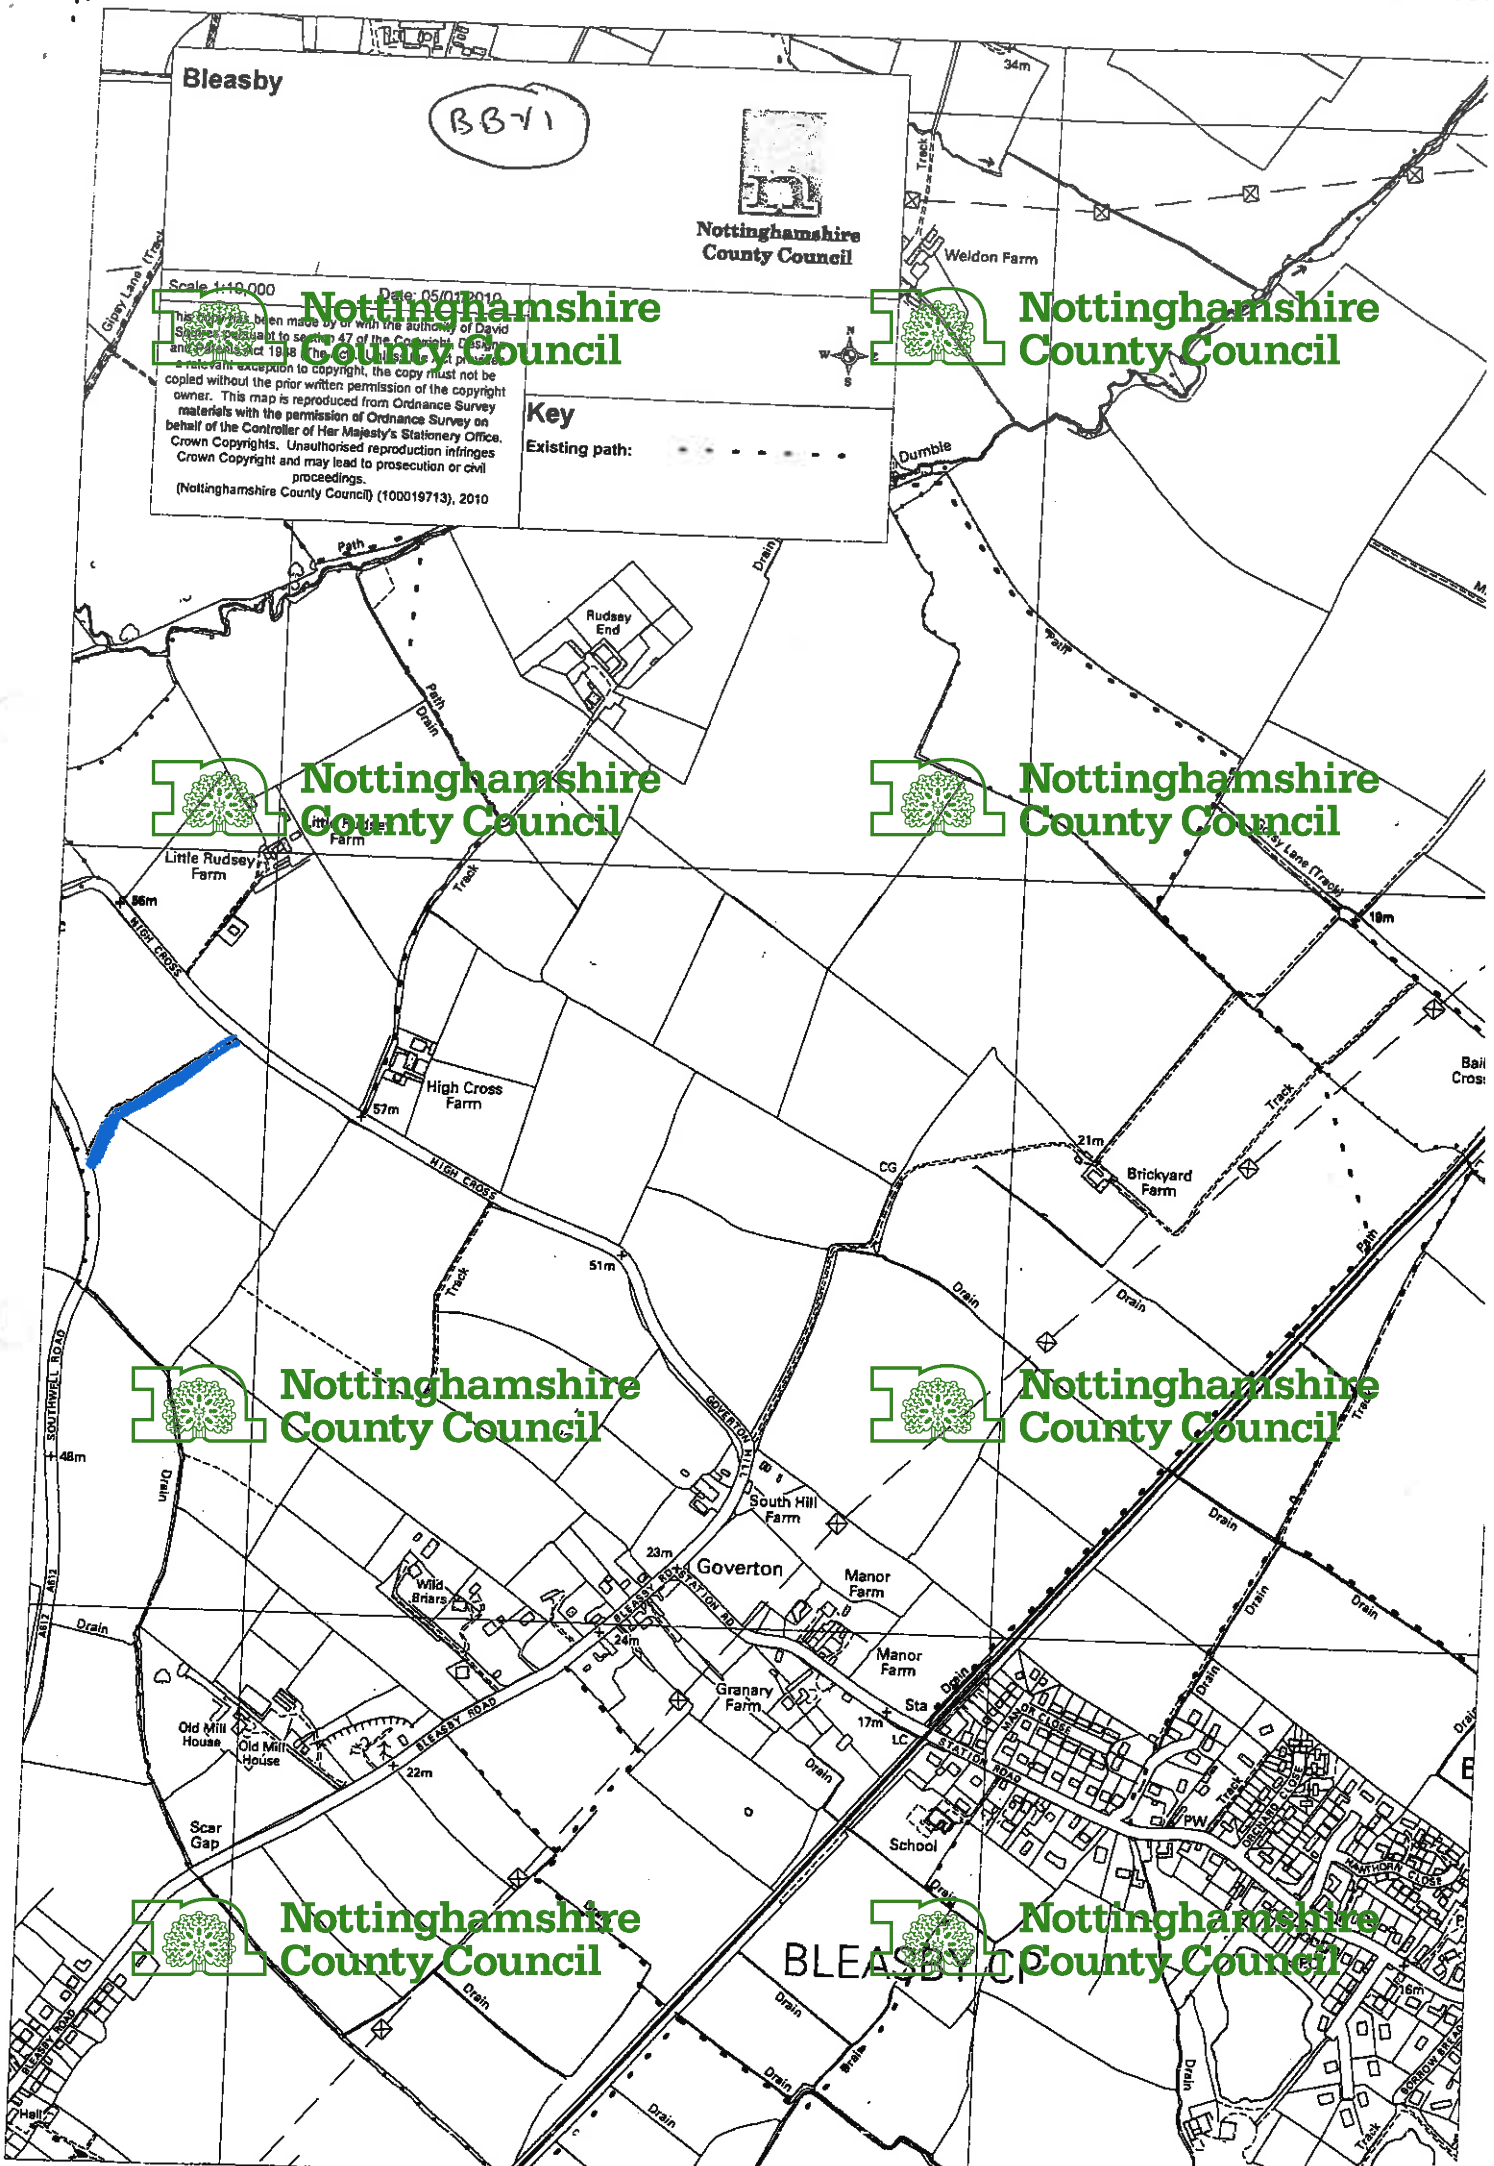

Bleasby

BB71

Nottinghamshire County Council

Scale 1:10,000 Date: 05/01/2010
 This map has been made by or with the authority of David
 Speed pursuant to section 47 of the Copyright, Designs
 and Patents Act 1988. The Ordnance Survey map which
 is the basis of this map is published under a Creative
 Commons Attribution-NonCommercial-ShareAlike license.
 Where a Creative Commons license does not apply, a Creative
 Commons license exception to copyright, the copy must not be
 copied without the prior written permission of the copyright
 owner. This map is reproduced from Ordnance Survey
 materials with the permission of Ordnance Survey on
 behalf of the Controller of Her Majesty's Stationery Office.
 Crown Copyrights. Unauthorised reproduction infringes
 Crown Copyright and may lead to prosecution or civil
 proceedings.
 (Nottinghamshire County Council) (100019713), 2010

Key

Existing path: - - - - -

Nottinghamshire County Council

Nottinghamshire County Council

BLEASBY