

Proposed sign mounted on 1no 76mm post, 2.3m mounted height to be installed 800mm from kerbline to allow 500mm offset to sign from carriageway edge

Proposed sign and flashing amber warning light mounted on 1 no.114mm board based post, 2.3m mounting height to be installed in the verge

Existing school warning patrol sign to be removed




Proposed sign mounted on 1no 76mm post, 2.3m mounted height to be installed 800mm from kerbline to allow 500mm offset to sign from carriageway edge

Existing warning sign to be retained

Proposed sign and flashing amber warning light mounted on 1 no.114mm board based post, 2.3m mounting height to be installed in the verge

Existing school patrol warning sign to be removed

Existing school warning sign to be retained

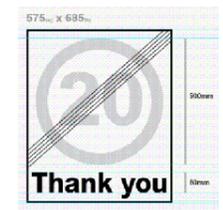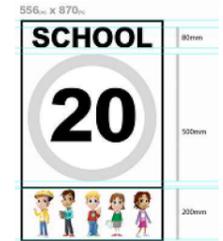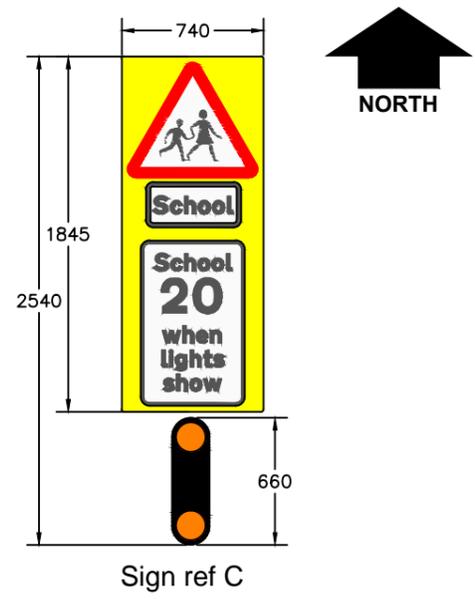

- Entrance to school
- Existing signs retained

Rev Status	Description	Drawn	Chkd	Auth	Date
20mph School Speed Limits					
Property No.	Project No.				
Fairfield Primary Academy Stapleford					
Scale	Drawn	S.M.	Date	28/4/14	
1:2000	Chkd	S.M.	Date	12/05/14	
	Auth		Traced	K.H.	
Drawing No.		Rev			
LR/P.H.IK.61415.02/13 C					

Nottinghamshire County Council
 Trent Bridge House, Fox Road,
 West Bridgford, Nottingham, NG2 6BJ
 Tel: 0300 500 80 80

© Nottinghamshire County Council