



APPLICATION FOR A MODIFICATION ORDER

WILDLIFE AND COUNTRYSIDE ACT 1981 NOTTINGHAMSHIRE DEFINITIVE MAP AND STATEMENT

To: COUNTRYSIDE ACCESS TEAM (TBH)
NOTTINGHAMSHIRE COUNTY COUNCIL
COUNTY HALL
WEST BRIDGFORD
NOTTINGHAMSHIRE NG2 7QP

We, COLLINGHAM PARISH COUNCIL
of 71 HIGH STREET, COLLINGHAM hereby apply for
an order under Section 53(2) of the Wildlife and Countryside Act 1981 modifying the Nottinghamshire
Definitive Map and Statement for the District of COLLINGHAM by

*1. deleting the route known as _____
_____ and running from
_____ to _____

*2. Adding the (footpath) (bridleway) (~~restricted byway~~) (~~byway open to all traffic~~) situated in the
Parish/Town of COLLINGHAM and running from
THE JUNCTION OF NORTH COLLINGHAM FP11 & SC FP9 to
SOUTH COLLINGHAM SA (ALONG EASTSIDE OF DITCH)

*3. (upgrading) (downgrading) to a (footpath) (bridleway) (restricted byway) (byway open to all
traffic) the route known as _____
and running from _____
to _____

*4. (varying) (adding to) the particulars relating to the route known as _____
_____ and running from _____
to _____
by _____

and shown on the map accompanying this application.

* Please complete the appropriate section.

We attach copies and list below the following documentary evidence (including statements of witness(es)) in support of this application, and acknowledge that the information submitted will be made publicly available.

DOCUMENTS

Dated 1 June 2007 Signed _____

Football Ground



Nottinghamshire
County Council

Scale 1:2500

Produced by: a t47

Date: 22/03/2017




NOT DEFINITIVE

Queries about path alignment should be made to the Definitive Map Team on 0115 9773708.

Public Rights of Way:

- Footpath
- Bridleway
- Byway Open to All Traffic
- Restricted Byway

This map is reproduced from Ordnance Survey materials with the permission of Ordnance Survey on behalf of the Controller of Her Majesty's Stationery Office. Crown copyrights. Unauthorised reproduction infringes Crown Copyright and may lead to prosecution or civil proceedings. (Nottinghamshire County Council) (100019713), 2017

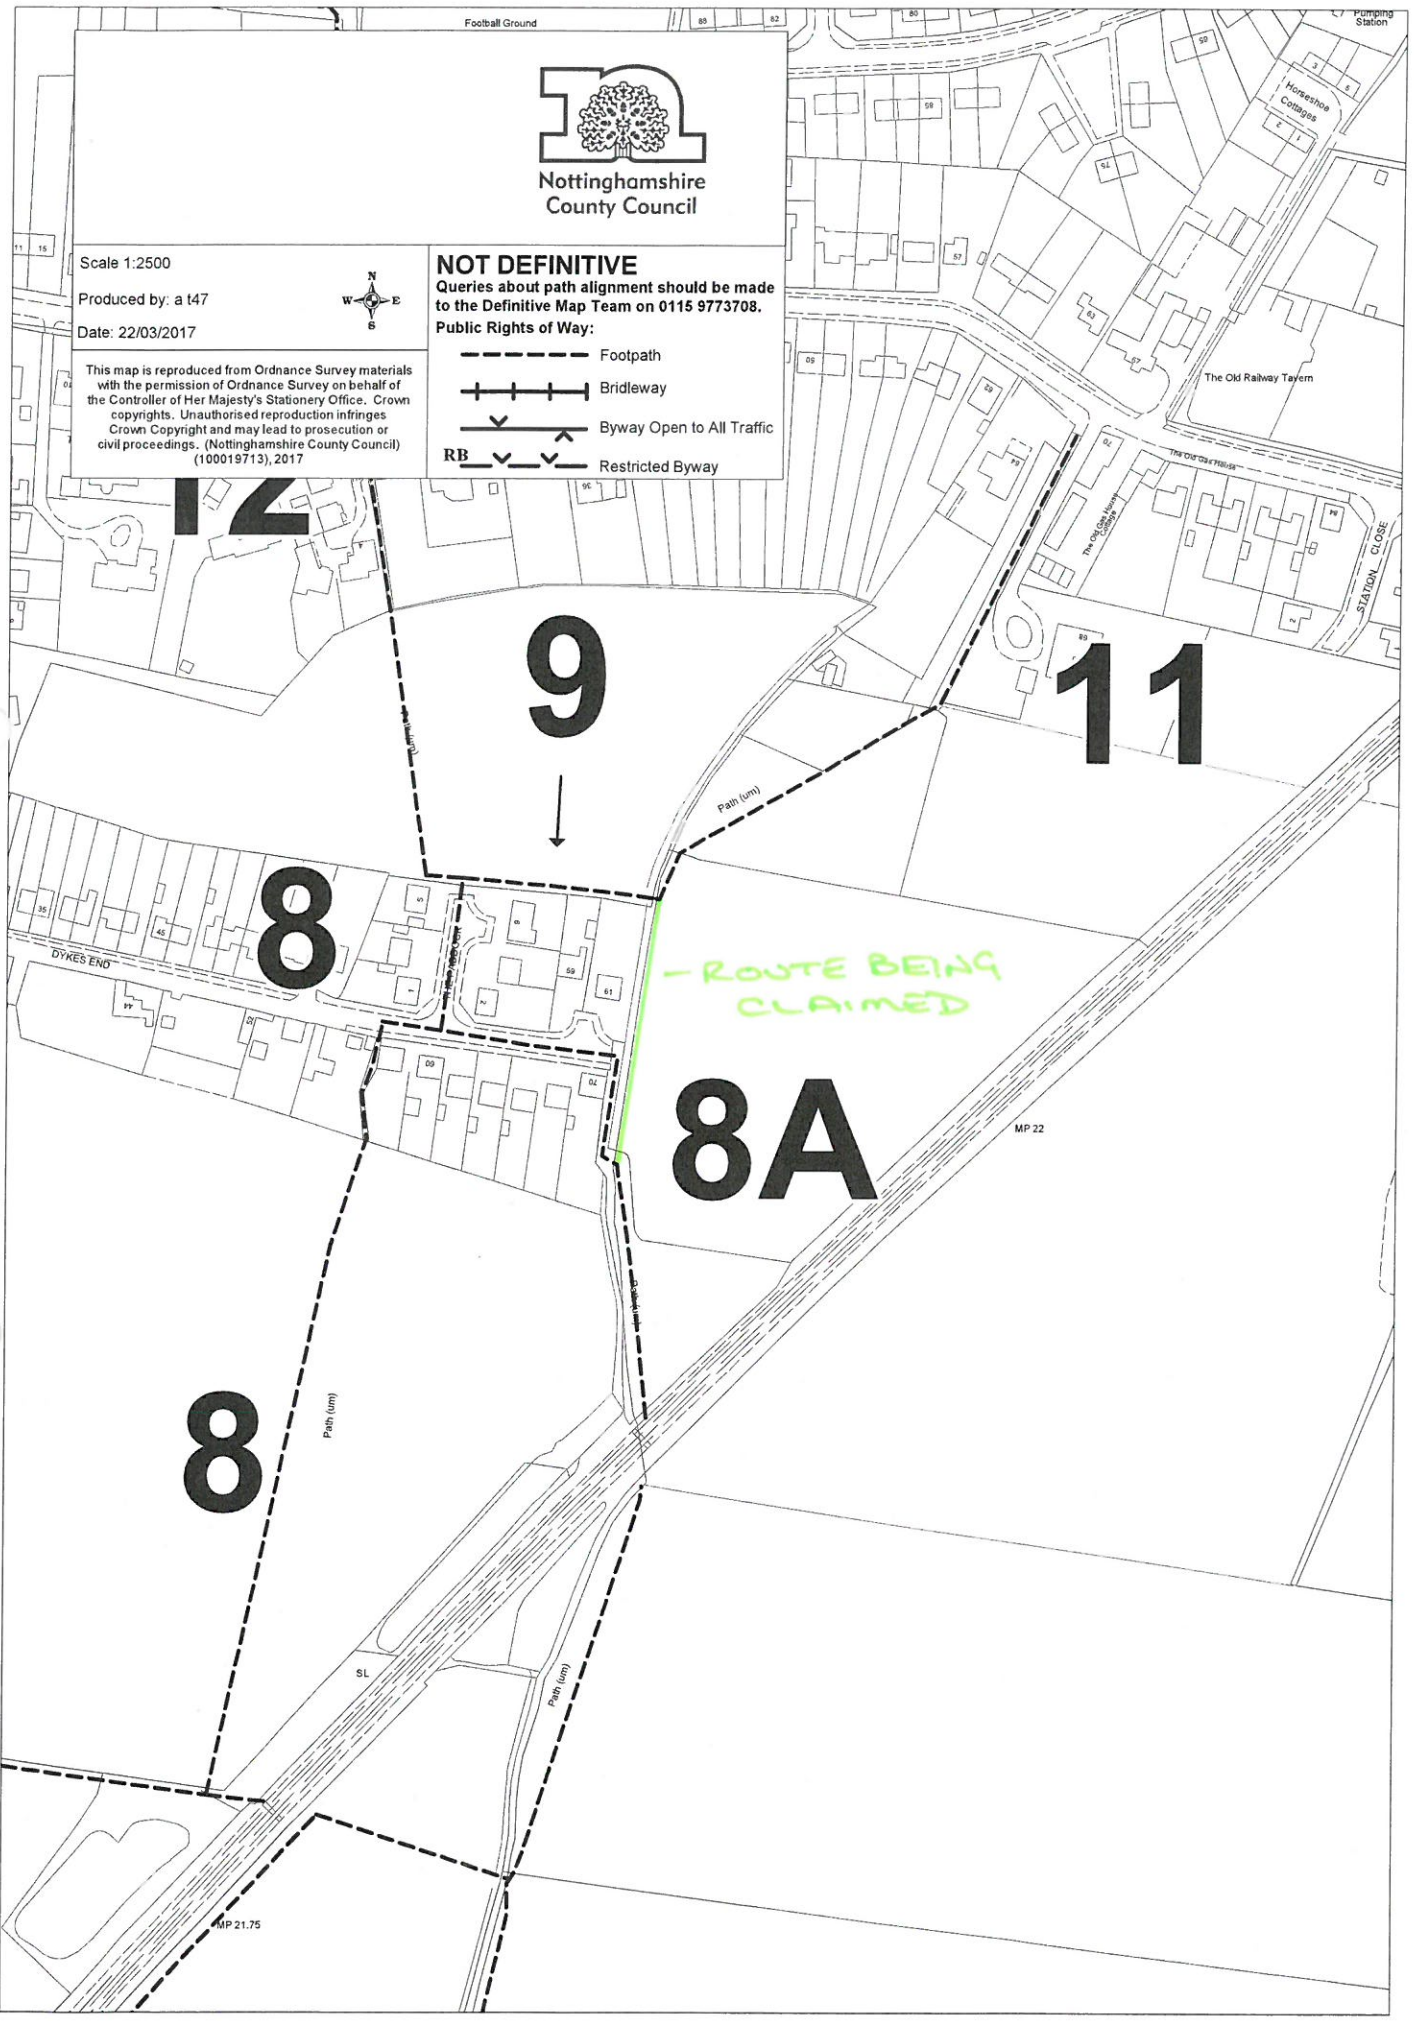

12

9

11

8

8A

- ROUTE BEING CLAIMED

8

MP 21.75

MP 22