



APPLICATION FOR A MODIFICATION ORDER

WILDLIFE AND COUNTRYSIDE ACT 1981 NOTTINGHAMSHIRE DEFINITIVE MAP AND STATEMENT

To: NOTTINGHAMSHIRE COUNTY COUNCIL
COUNTRYSIDE ACCESS
COMMUNITIES
TRENT BRIDGE HOUSE
FOX ROAD
WEST BRIDGFORD
NOTTINGHAMSHIRE NG2 6BJ

~~I/We~~, MARY MILLS
of 21 LEIVERS AVENUE, ARNOLD, NOTTINGHAM hereby apply for
an order under Section 53(2) of the Wildlife and Countryside Act 1981 modifying the Nottinghamshire
Definitive Map and Statement for the District of BROXTOWE by

- *1. deleting the route known as _____
_____ and running from
_____ to _____
- *2. Adding the (footpath) (bridleway) (restricted byway) (byway open to all traffic) situated in the
Parish/Town of _____ and running from
_____ to _____
- *3. (~~upgrading~~) (~~downgrading~~) to a (~~footpath~~) (bridleway) (~~restricted byway~~) (~~byway open to all traffic~~) the route known as BEESTON FP 69
and running from BEESTON FP BW 70 (BARTON LANE)
to COUNTY BOUNDARY WITH DERBYSHIRE (LONGEATON FP 12)
- *4. (varying) (adding to) the particulars relating to the route known as _____
_____ and running from _____
to _____
by _____

and shown on the map accompanying this application.


* Please complete the appropriate section.

~~I/We~~ attach copies and list below the following documentary evidence (including statements of witness(es)) in support of this application, and acknowledge that the information submitted will be made publicly available.

DOCUMENTS

O.S. 25" maps 45.3 (1901) and 45.4 (1900)
CHAPMAN MAP (1774). BARTON IN FABIS PARISH SCHEDULE
MAP (REVISION OF 1938/1939)

Dated 23/11/2012 Signed _____

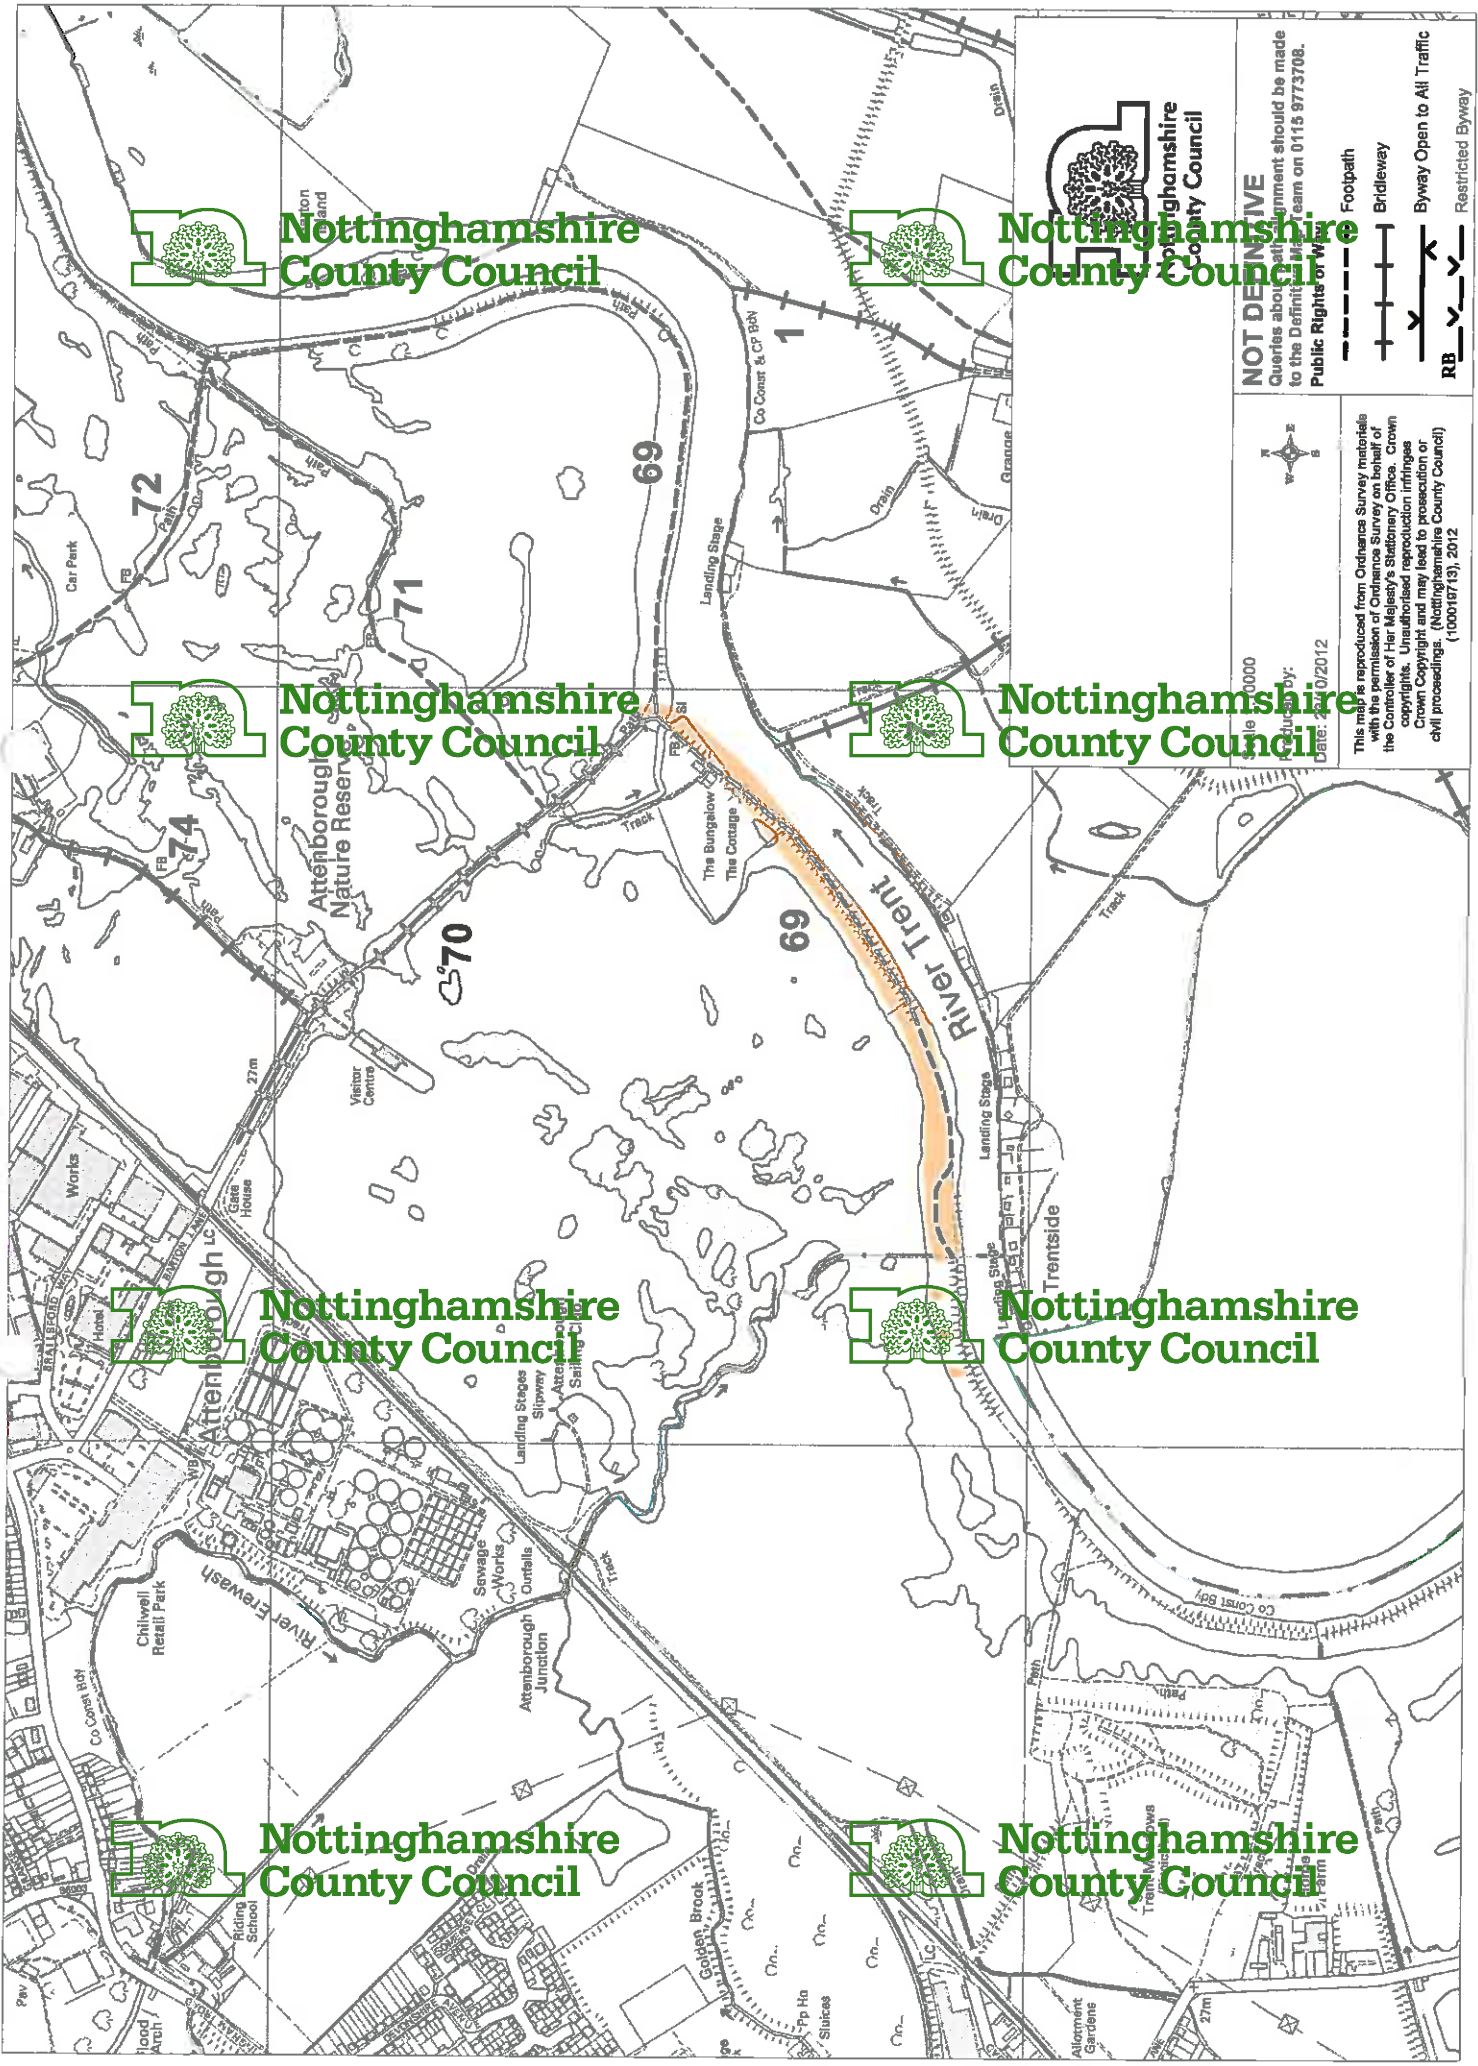

**Nottinghamshire
County Council**

**Nottinghamshire
County Council**

NOT DEFINITIVE
 Queries about this agreement should be made
 to the Definition Team on 0115 973708.
Public Rights of Way

- Footpath
- Bridleway
- Byway Open to All Traffic
- Restricted Byway

Scale: 1:10000
 Date: 14/07/2012
 This map is reproduced from Ordnance Survey material
 with the permission of Ordnance Survey on behalf of
 the Controller of Her Majesty's Stationery Office. Crown
 Copyright. Unauthorised reproduction infringes
 Crown Copyright and may lead to prosecution or
 civil proceedings. (Nottinghamshire County Council)
 (100018713), 2012