



# APPLICATION FOR A MODIFICATION ORDER

## WILDLIFE AND COUNTRYSIDE ACT 1981 NOTTINGHAMSHIRE DEFINITIVE MAP AND STATEMENT

To: COUNTRYSIDE ACCESS TEAM (TBH)  
NOTTINGHAMSHIRE COUNTY COUNCIL  
COUNTY HALL  
WEST BRIDGFORD  
NOTTINGHAMSHIRE NG2 7QP

I/We, VICTOR AIRD - Coordinating Claim  
of THE OLD BARN, PINGUEY LANE, STAYTHORPE hereby apply for  
an order under Section 53(2) of the Wildlife and Countryside Act 1981 modifying the Nottinghamshire  
Definitive Map and Statement for the District of STAYTHORPE by

- \*1. deleting the route known as \_\_\_\_\_  
\_\_\_\_\_ and running from  
\_\_\_\_\_ to \_\_\_\_\_
- \*2. Adding the (footpath) (~~bridleway~~) (~~restricted byway~~) (~~byway open to all traffic~~) situated in the  
Parish/Town of STAYTHORPE and running from  
PINGUEY LANE to  
PINGUEY DYKE FOOTPATH 3
- \*3. (upgrading) (downgrading) to a (footpath) (bridleway) (restricted byway) (byway open to all  
traffic) the route known as \_\_\_\_\_  
and running from \_\_\_\_\_  
to \_\_\_\_\_
- \*4. (varying) (adding to) the particulars relating to the route known as \_\_\_\_\_  
\_\_\_\_\_ and running from \_\_\_\_\_  
to \_\_\_\_\_  
by \_\_\_\_\_

and shown on the map accompanying this application.

\* Please complete the appropriate section.

I/We attach copies and list below the following documentary evidence (including statements of  
witness(es)) in support of this application, and acknowledge that the information submitted will be  
made publicly available.

### DOCUMENTS

Covering letter  
Completed evidence forms

Dated 3/11/2015 Signed \_\_\_\_\_

Working copy of the Definitive Map



Scale 1:2500



Date: 09/10/2015

This map is reproduced from Ordnance Survey materials with the permission of Ordnance Survey on behalf of the Controller of Her Majesty's Stationary Office. Crown copyrights. Unauthorised reproduction infringes Crown Copyright and may lead to prosecution or civil proceedings. (Nottinghamshire County Council) (100019713), 2015

**NOT DEFINITIVE**

Queries about path alignment should be made to the Definitive Map Team on 0115 9773708.


**Public Rights of Way:**

- Footpath
- Bridleway
- Byway Open to All Traffic
- Restricted Byway

*Latham Farms Section*

*Manor Farm Section*

Staythorpe

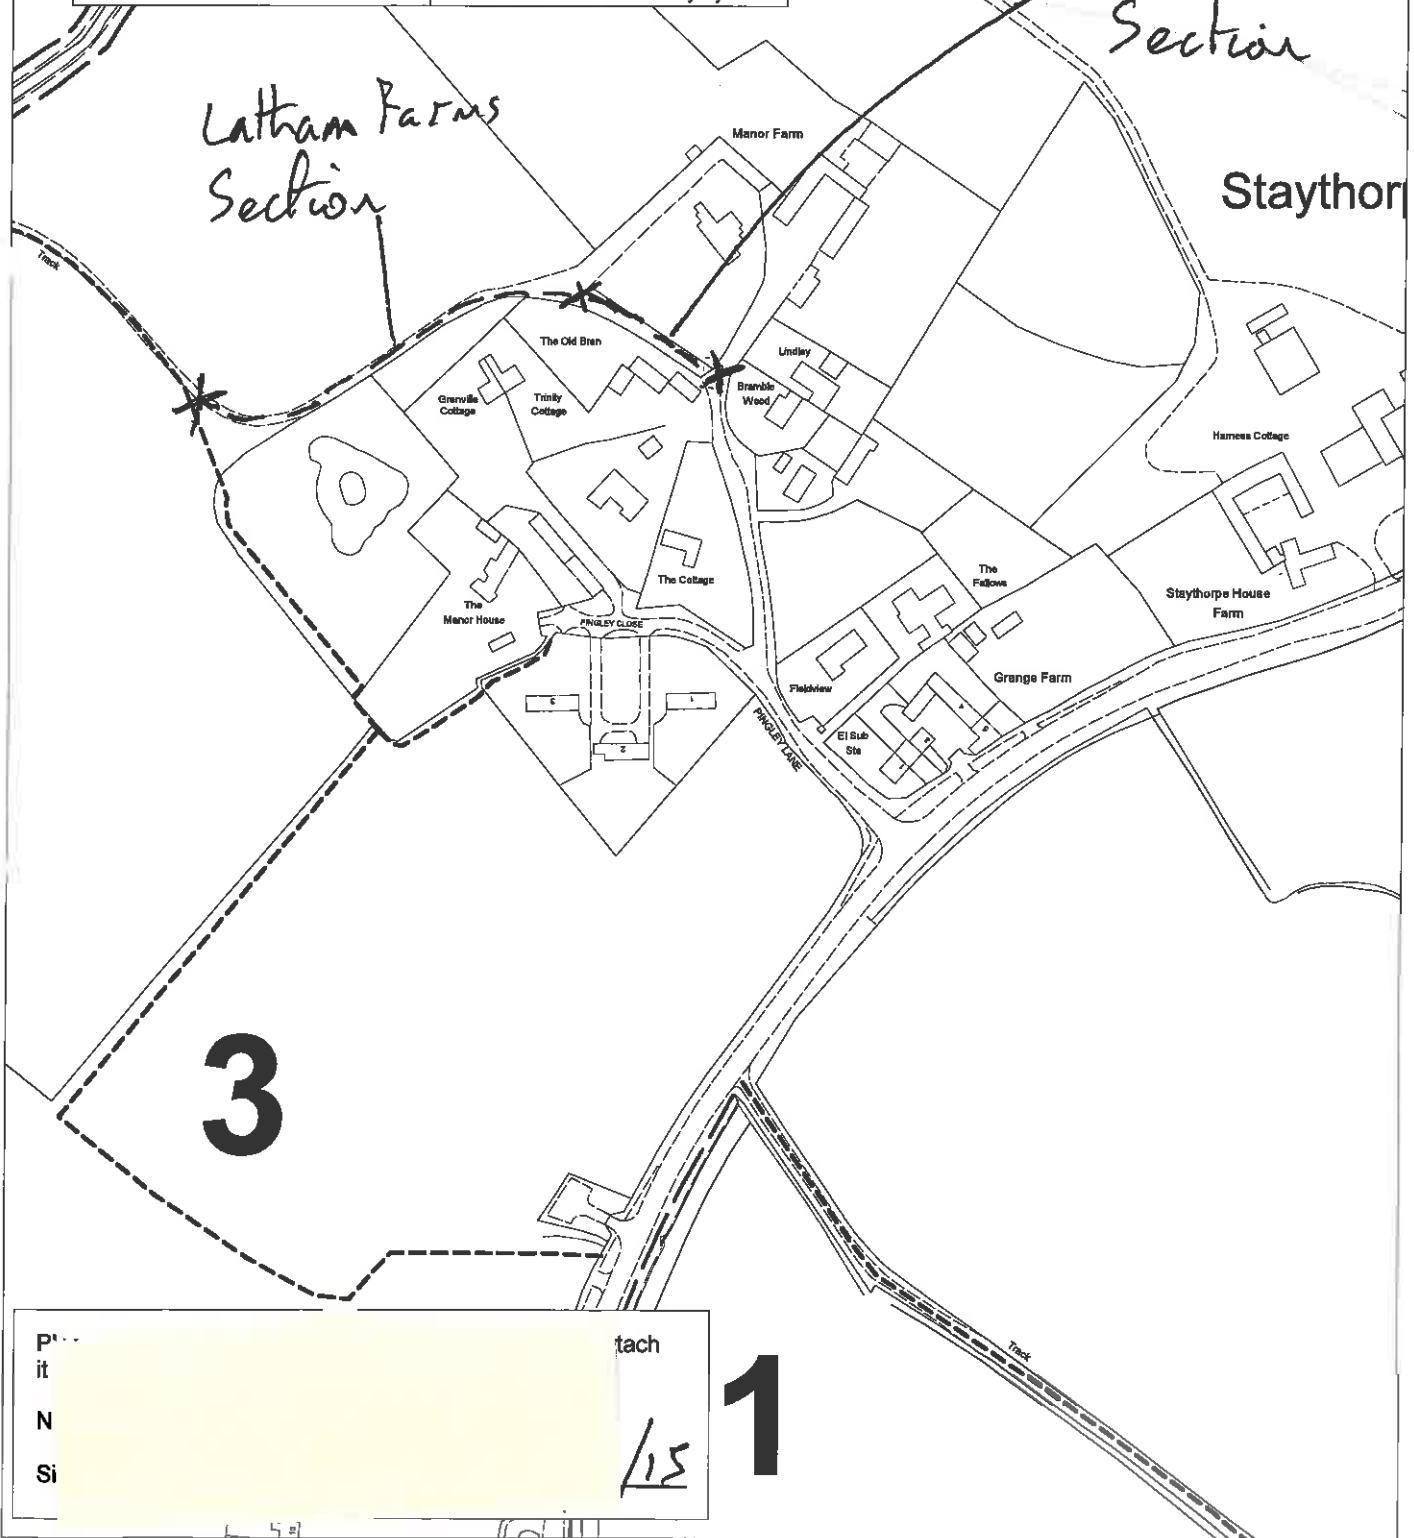

Part of the Definitive Map

Nottinghamshire County Council

1/15