

①

1308



Nottinghamshire
County Council

APPLICATION FOR A MODIFICATION ORDER

WILDLIFE AND COUNTRYSIDE ACT 1981 NOTTINGHAMSHIRE DEFINITIVE MAP AND STATEMENT

To: COUNTRYSIDE ACCESS TEAM (TBH)
NOTTINGHAMSHIRE COUNTY COUNCIL
COUNTY HALL
WEST BRIDGFORD
NOTTINGHAMSHIRE NG2 7QP

I/~~we~~, ELIZABETH (LIBBY) STENNETT
of 20 GROVE PARK, MISTERTON, DONCASTER hereby apply for
an order under Section 53(2) of the Wildlife and Countryside Act 1981 modifying the Nottinghamshire
Definitive Map and Statement for the District of BASSETLAW by

- *1. deleting the route known as _____
_____ and running from
_____ to _____
- *2. ~~Adding~~ the (footpath) (~~bridleway~~) (~~restricted byway~~) (~~byway open to all traffic~~) situated in the
Parish/Town of MISTERTON and running from
HAXEY GATE BRIDGE to
CLINGLEY PUMPING STATION
- *3. (upgrading) (downgrading) to a (footpath) (bridleway) (restricted byway) (byway open to all
traffic) the route known as _____
and running from _____
to _____
- *4. (varying) (adding to) the particulars relating to the route known as _____
_____ and running from _____
to _____
by _____

and shown on the map accompanying this application.


* Please complete the appropriate section.

I/~~we~~ attach copies and list below the following documentary evidence (including statements of
witness(es)) in support of this application, and acknowledge that the information submitted will be
made publicly available.

DOCUMENTS

Historic use together with User Evidence
forms submitted to Notts county council

Dated 15.2.22 Signed _____

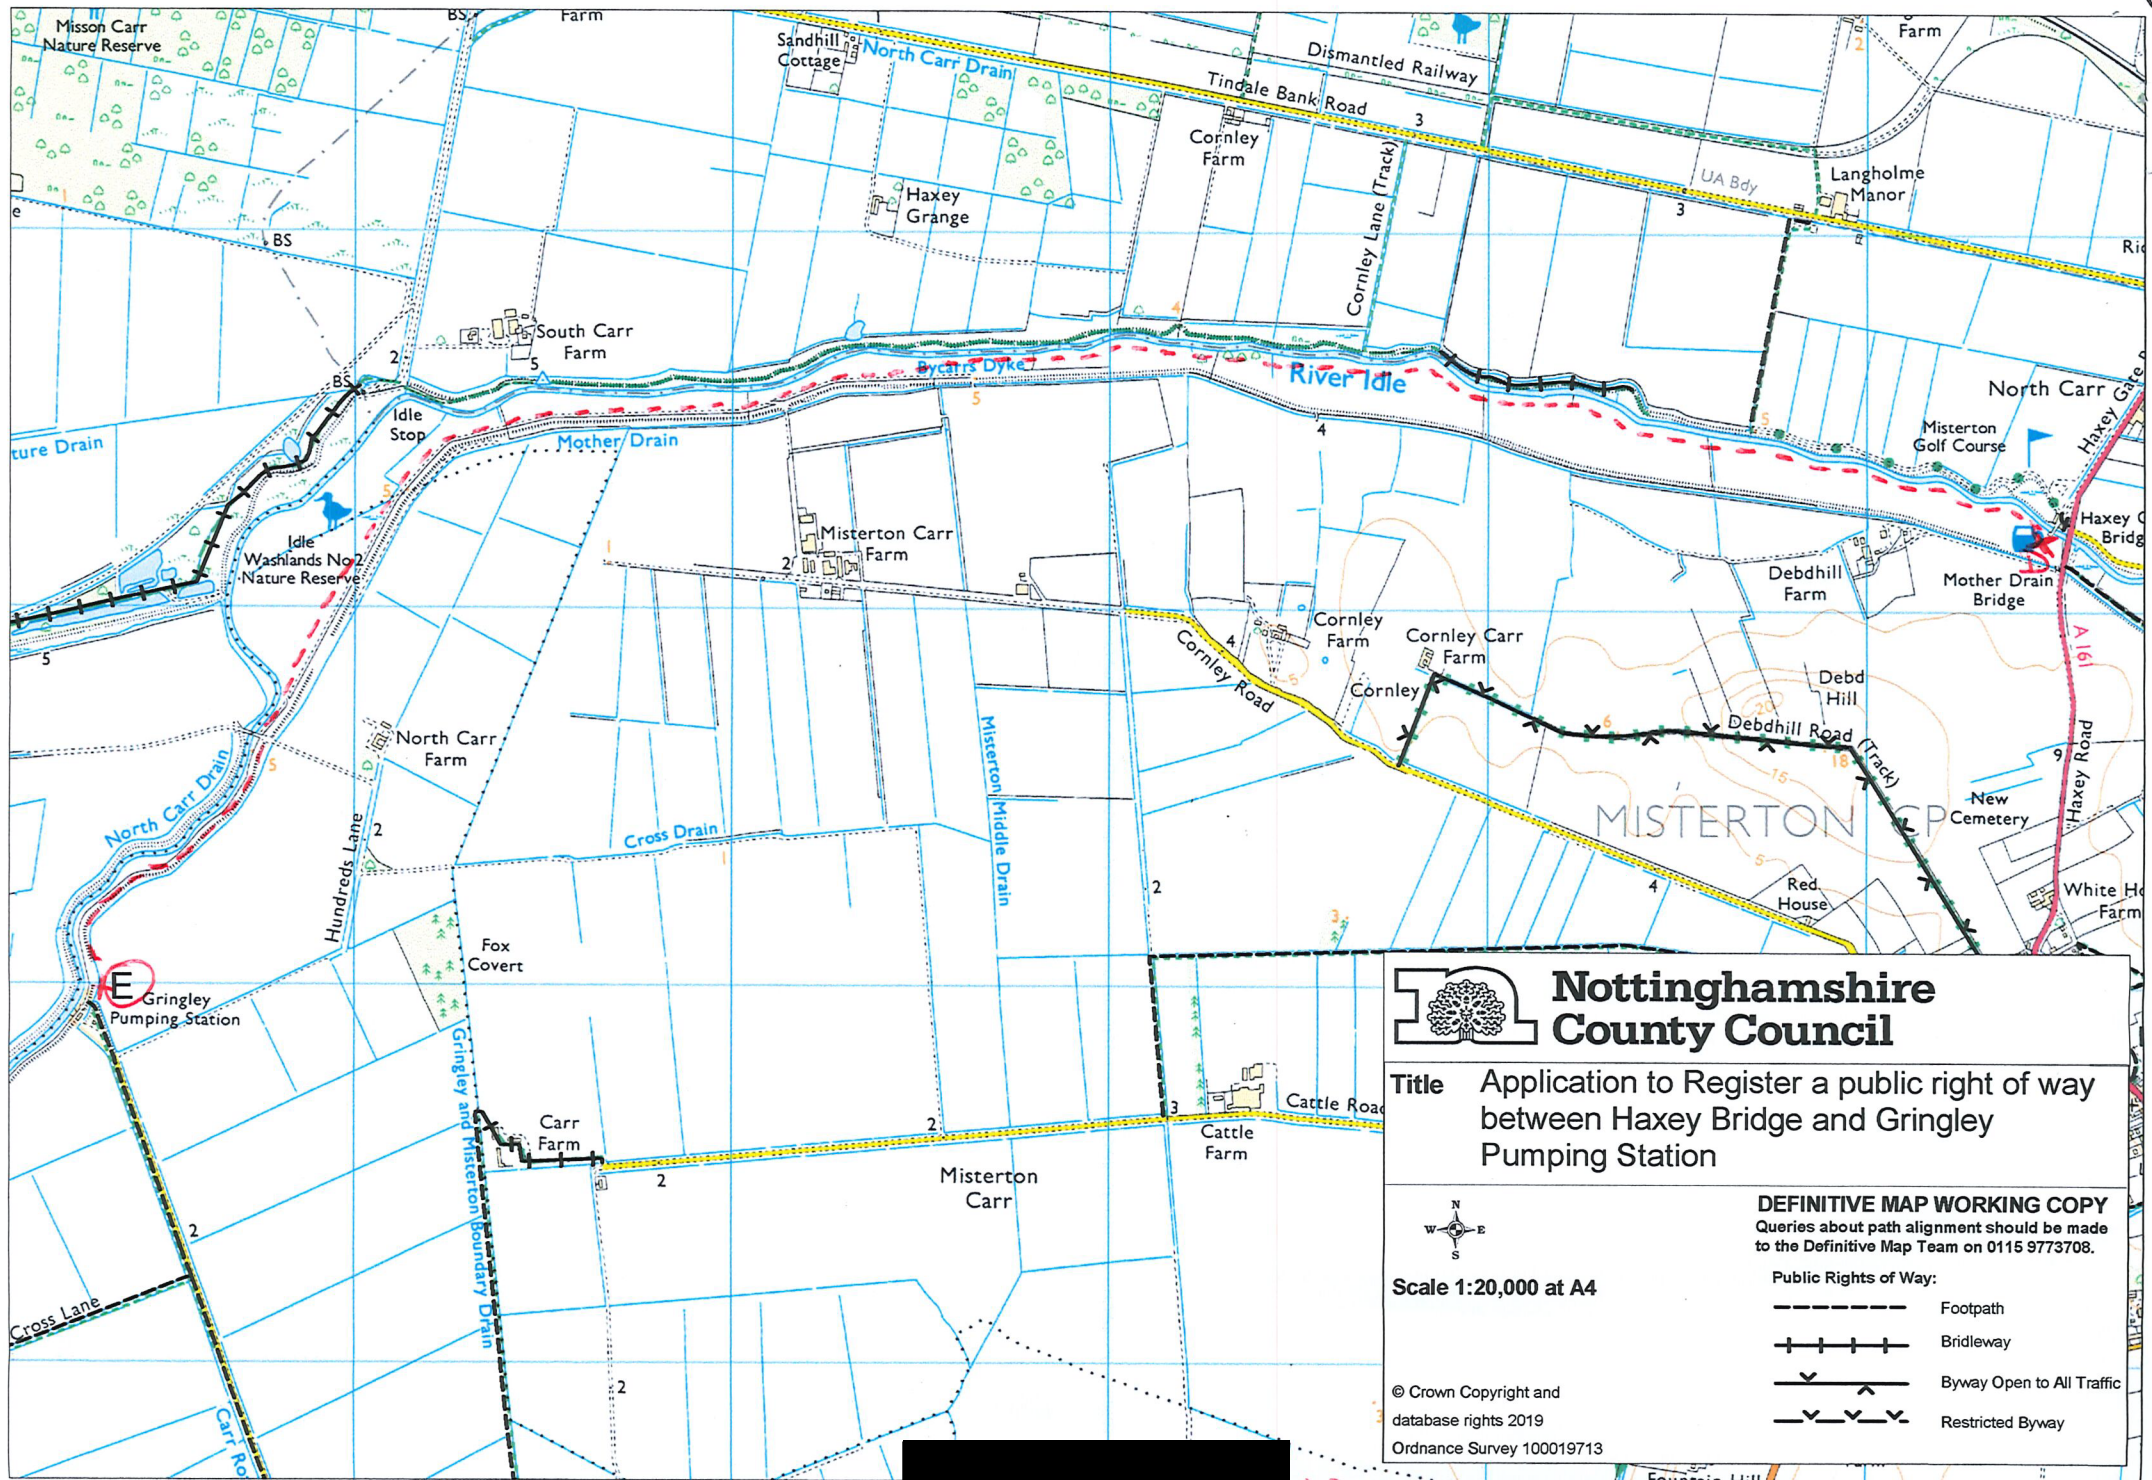

Nottinghamshire County Council

Title Application to Register a public right of way
between Haxey Bridge and Gringley
Pumping Station



Scale 1:20,000 at A4

© Crown Copyright and
database rights 2019
Ordnance Survey 100019713

DEFINITIVE MAP WORKING COPY
Queries about path alignment should be made
to the Definitive Map Team on 0115 9773708.

Public Rights of Way:

- | | |
|---------------|---------------------------|
| ----- | Footpath |
| + + + + + | Bridleway |
| ^ ^ ^ ^ ^ | Byway Open to All Traffic |
| - v - v - v - | Restricted Byway |

----- D + E

18.02.22