

2

1307



# APPLICATION FOR A MODIFICATION ORDER

## WILDLIFE AND COUNTRYSIDE ACT 1981 NOTTINGHAMSHIRE DEFINITIVE MAP AND STATEMENT

To: COUNTRYSIDE ACCESS TEAM (TBH)  
NOTTINGHAMSHIRE COUNTY COUNCIL  
COUNTY HALL  
WEST BRIDGFORD  
NOTTINGHAMSHIRE NG2 7QP

Also sent to  
N. Lincs C.C.

I/We, ELIZABETH STENNETT

of 20 GROVE PARK, MISTERTON, DONCASTER DN10 4HF hereby apply for  
an order under Section 53(2) of the Wildlife and Countryside Act 1981 modifying the Nottinghamshire  
Definitive Map and Statement for the District of BASSETLAW & N. Lincs by

\*1. deleting the route known as \_\_\_\_\_  
\_\_\_\_\_ and running from  
\_\_\_\_\_ to \_\_\_\_\_

\*2. Adding the (footpath) (~~bridleway~~) (~~restricted byway~~) (~~byway open to all traffic~~) situated in the  
Parish/Town of Nestwoodside, Cringley, Misson and running from  
N. Lincs Bridleway HAXE11b to  
CRINGLEY PUMPING STATION

\*3. (upgrading) (downgrading) to a (footpath) (bridleway) (restricted byway) (byway open to all  
traffic) the route known as \_\_\_\_\_  
and running from \_\_\_\_\_  
to \_\_\_\_\_

\*4. (varying) (adding to) the particulars relating to the route known as \_\_\_\_\_  
\_\_\_\_\_ and running from \_\_\_\_\_  
to \_\_\_\_\_  
by \_\_\_\_\_

and shown on the map accompanying this application.


\* Please complete the appropriate section.


I/We attach copies and list below the following documentary evidence (including statements of witness(es)) in support of this application, and acknowledge that the information submitted will be made publicly available.

### DOCUMENTS

Historic use together with user evidence forms submitted to Notts County Council

Dated 18.02.22 Signed \_\_\_\_\_

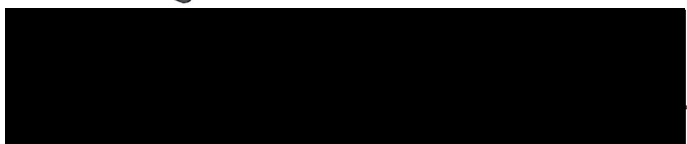

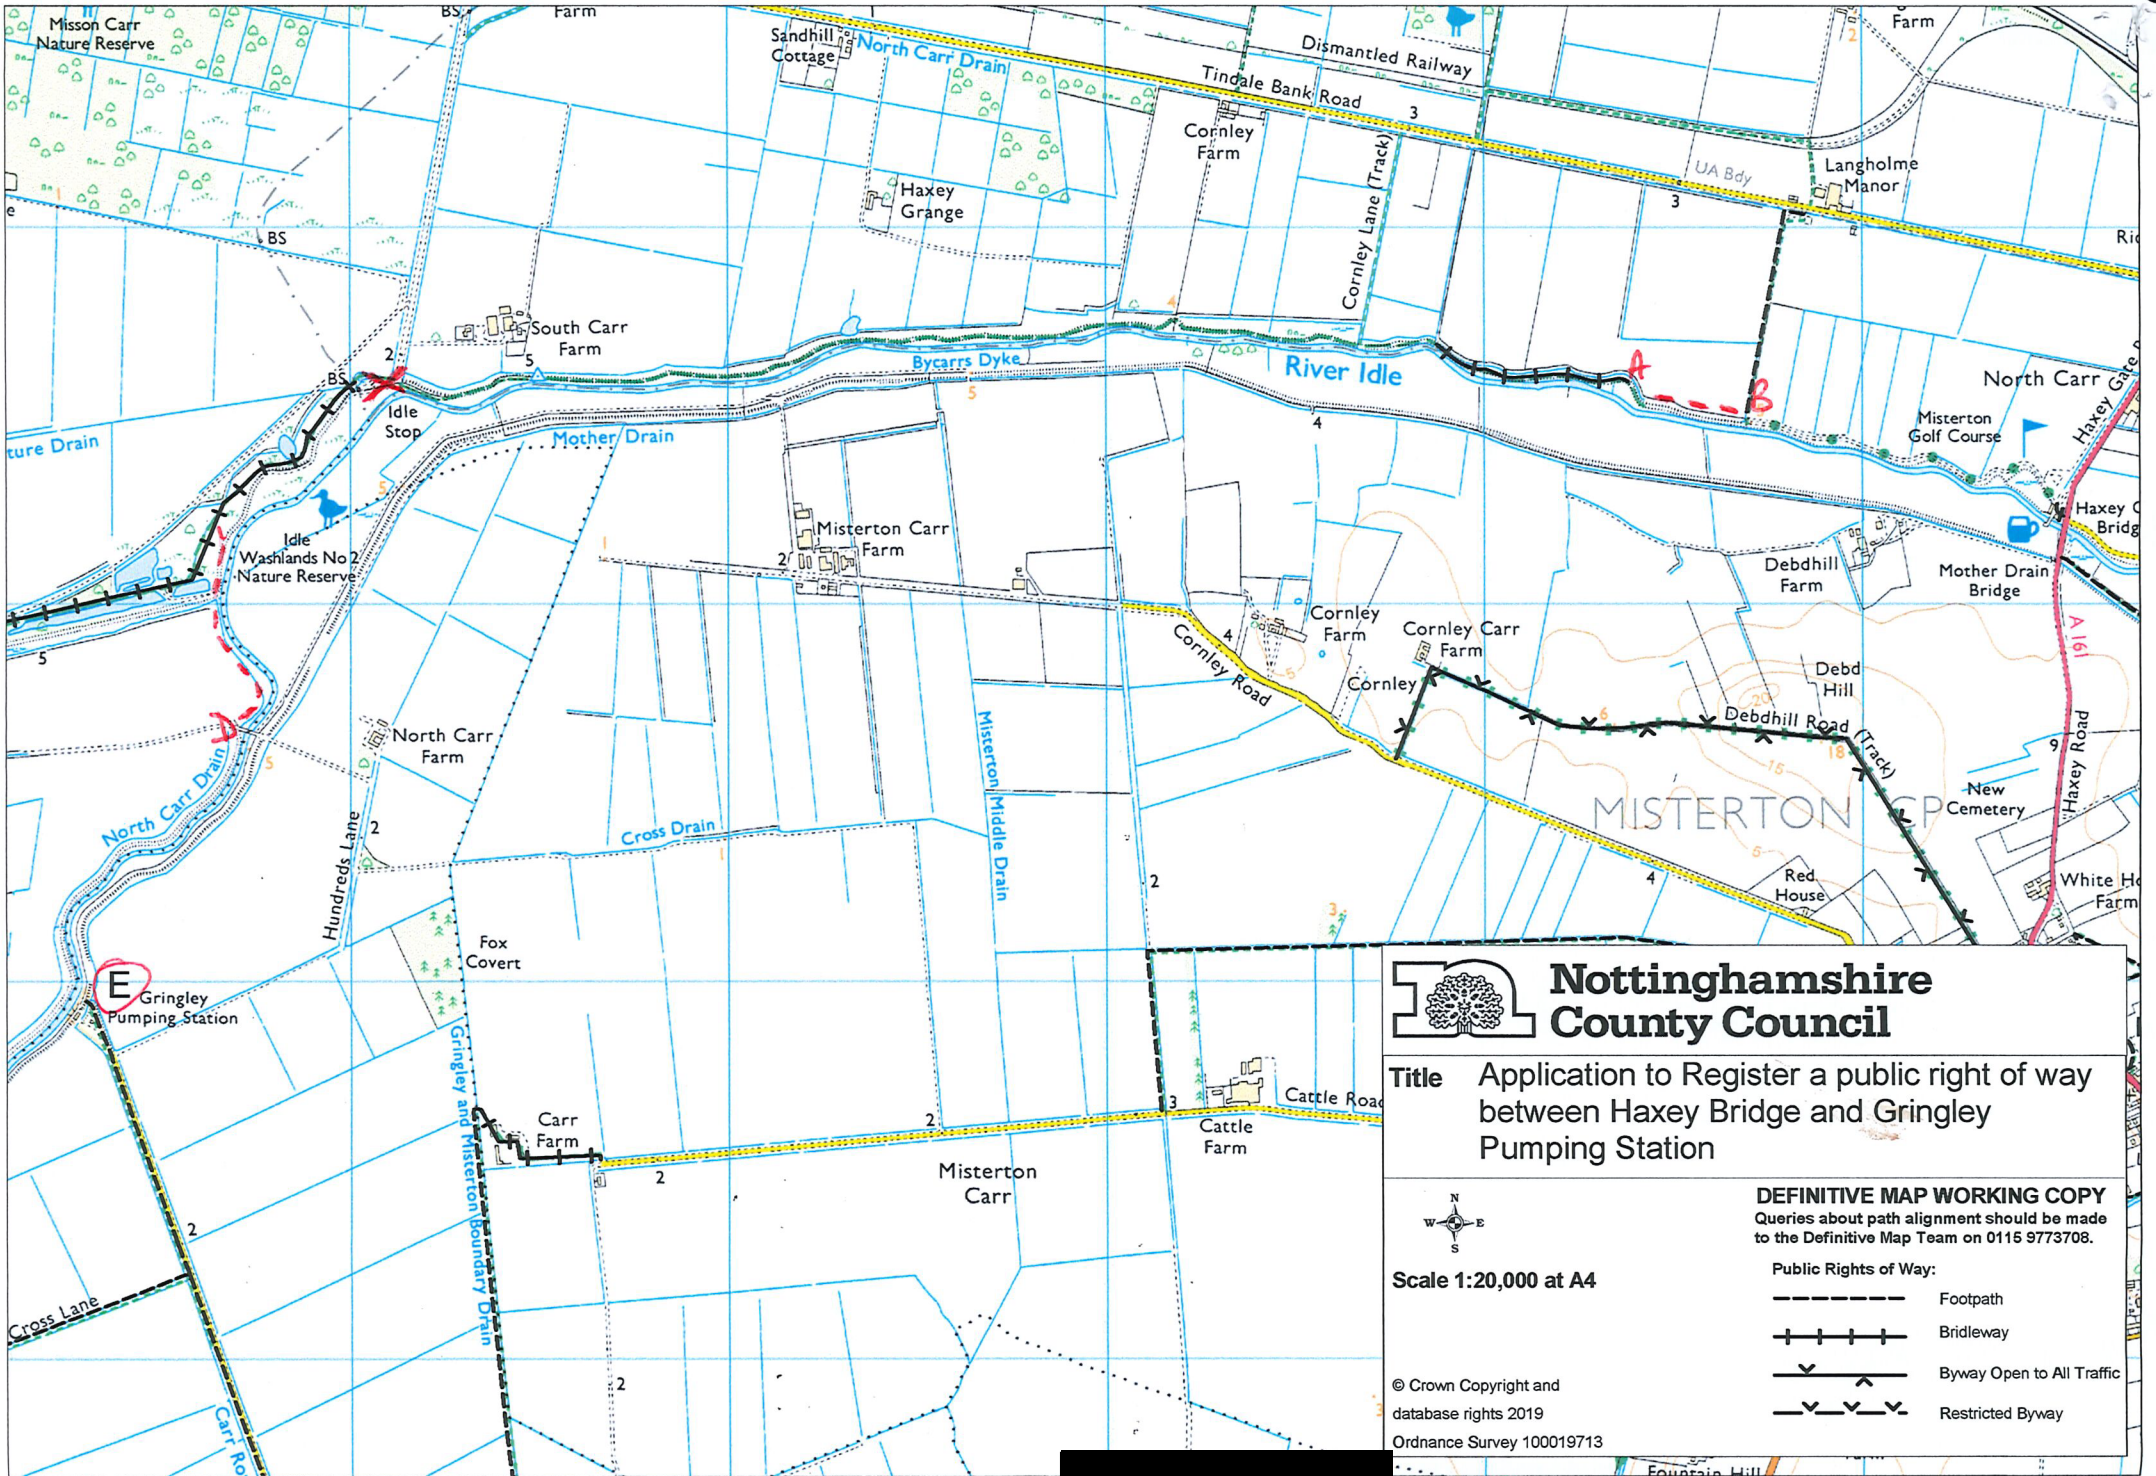

**Nottinghamshire County Council**

**Title** Application to Register a public right of way between Haxey Bridge and Gringley Pumping Station

Scale 1:20,000 at A4

© Crown Copyright and database rights 2019  
Ordnance Survey 100019713

**DEFINITIVE MAP WORKING COPY**  
Queries about path alignment should be made to the Definitive Map Team on 0115 9773708.

**Public Rights of Way:**

- Footpath
- + + + + + Bridleway
- ^ ^ ^ ^ ^ Byway Open to All Traffic
- - - - - Restricted Byway

A to B ---

X to D

--- 18.02.22 ---