

APPLICATION FOR A MODIFICATION ORDER

WILDLIFE AND COUNTRYSIDE ACT 1981 NOTTINGHAMSHIRE DEFINITIVE MAP AND STATEMENT.

To: Countryside Access Team (TBH), Nottinghamshire County Council,
County Hall, West Bridgford, Nottinghamshire. NG2 7QP.

 
I, Richard James Maher of 199A Main Street, Newthorpe, Nottingham. NG16 2DL hereby apply for an order under section 53(2) of the Wildlife and Countryside Act 1981 modifying the Nottinghamshire Definitive Map and Statement for Greasley, within the District Council of Broxtowe by:

Deleting a section of the footpath known as Greasley Footpath 32 running from left of farm gate (point B) to the Parish Schedule 59 stile (point C) to the location of the Parish Schedule 60 Stone footbridge (point D), and marked on the attached map with the red line.

I attach copies and list below the following documentary evidence (including statements of witnesses) in support of this application and acknowledge that the information submitted will be made publically available.

Documents accompanying this application are listed on page 2 of the application.

Signed



Richard James Maher

Dated: 29th March 2023

Map Modification Order Application Map

Greasley Footpath 32

Legend

Plan showing the location of
Greasley Footpath No. 32




Nottinghamshire
County Council

Scale 1:1128 printed on A4

Line of path taken
from the 1938
25" plan

This map is reproduced from Ordnance Survey materials
with the permission of Ordnance Survey on behalf of
the Controller of Her Majesty's Stationery Office. Crown
copyrights. Unauthorised reproduction infringes
Crown Copyright and may lead to prosecution or
civil proceedings. (Nottinghamshire County Council)
(100019713), 2014

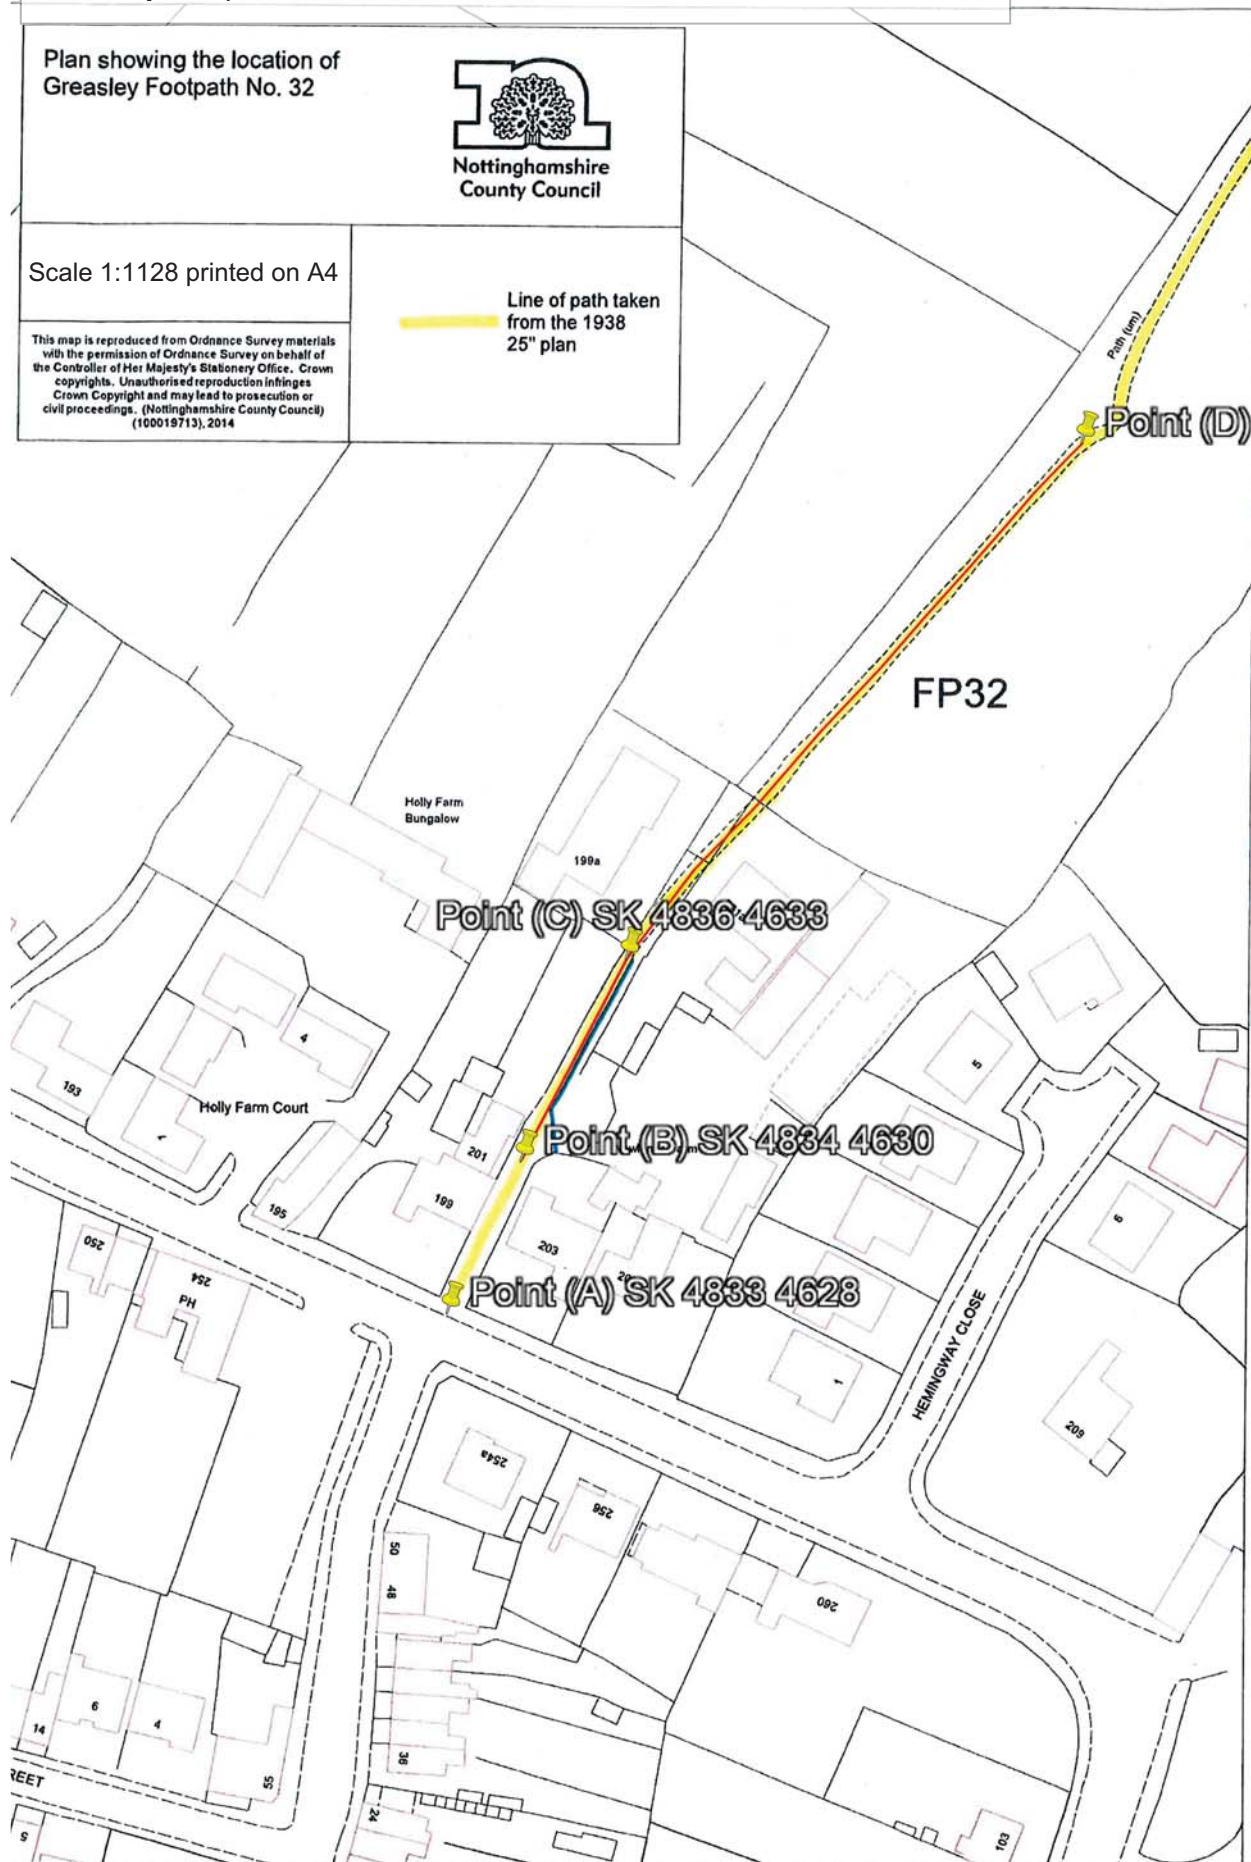

FP32

Holly Farm
Bungalow

Point (C) SK 4836 4633

Point (B) SK 4834 4630

Point (A) SK 4833 4628

Point (D) SK 4842 4641

HEMMINGSWAY CLOSE

100 m

Google Earth

