

WILDLIFE AND COUNTRYSIDE ACT 1981

THE NOTTINGHAMSHIRE (AREA 7) DEFINITIVE MAP AND STATEMENT

THE NOTTINGHAMSHIRE COUNTY COUNCIL  
(KINGS CLIPSTONE FOOTPATH NO.11 AND CLIPSTONE FOOTPATH NO.24)  
MODIFICATION ORDER 2021

This Order is made by the Nottinghamshire County Council under Section 53(2)(b) of the Wildlife & Countryside Act 1981 ("the Act") because it appears to that Authority that the Nottinghamshire (Area 7) Definitive Map and Statement require modification in consequence of the occurrence of an event specified in Section 53(3)(b) of the Act, namely, the expiration, in relation to any way in the area to which the map relates, of any period such that the enjoyment by the public of the way during that period raises a presumption that the way has been dedicated as a public path.

The Authority have consulted with every Local Authority whose area includes land to which the Order relates.


The Nottinghamshire County Council hereby order that:

1. For the purposes of this Order the relevant date is 1<sup>st</sup> January 2021.
2. The Nottinghamshire (Area 7) Definitive Map and Statement shall be modified as described in Part I and Part II of the Schedule and shown on the Map attached to this Order.
3. This Order shall take effect on the date it is confirmed and may be cited as "The Nottinghamshire County Council (Kings Clipstone Footpath No.11 and Clipstone Footpath No.24) Modification Order 2021".

THE COMMON SEAL of THE )  
 )  
NOTTINGHAMSHIRE COUNTY COUNCIL )  
 )  
was hereunto affixed )  
 )  
this 14th day of May 2021 )  
 )  
in the presence of:- )



SEAL REGISTER  
NO: 48691

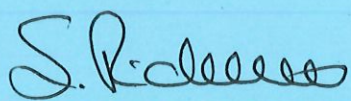  
AUTHORISED SIGNATORY

The foregoing order is hereby confirmed  
subject to the red ink modifications thereon

**Jennifer Ingram**

An Inspector appointed by The Secretary  
of State for Environment, Food and  
Rural Affairs



THE NOTTINGHAMSHIRE COUNTY COUNCIL  
(KINGS CLIPSTONE FOOTPATH NO.11 AND CLIPSTONE FOOTPATH NO.24)  
MODIFICATION ORDER 2021

SCHEDULE

PART I

Modification of Definitive Map

Description of the Path or Way to be added

Kings Clipstone Footpath No.11

5920 6467

Commencing at a point, grid reference SK~~5919 6466~~, at the junction with Kings Clipstone Bridleway No.4, and proceeding in a generally south-easterly then south-south-easterly direction for a distance of approximately 775 metres to a point, SK5962 6405, at the junction with Clipstone Footpath No.24.

Width	Between 1.2 and 2.0 metres
Limitations	None

Clipstone Footpath No.24

Commencing at a point, SK5962 6405, at the junction with Kings Clipstone Footpath No.11, and proceeding in a generally south-south-easterly direction for a distance of approximately 11 metres to a point, SK5962 6404, at the junction with Cavendish Way.

Width	1.2 metres
Limitations	None



THE NOTTINGHAMSHIRE COUNTY COUNCIL  
(KINGS CLIPSTONE FOOTPATH NO.11 AND CLIPSTONE FOOTPATH NO.24)  
MODIFICATION ORDER 2021

PART II

Modification of Definitive Statement

Description of the Path or Way to be added


**The Definitive Statement for the Parish of Kings Clipstone shall be amended as follows**

Status and Path No.	Footpath 11
O. S. Sheet No:	SK56SE
Approx. Length:	775 metres <span style="color: red;">5920 6467</span>
Width:	2.0 metres between SK <del>5919 6466</del> and SK5936 6451 1.2 metres between SK5936 6451 and SK5962 6405 <del>At SK5920 6466 there is a gap in a hedgerow reducing the width at this point to 1.3 metres.</del>
Starting Point:	<span style="color: red;">SK 5920 6467</span> <span style="color: red;">→</span> SK <del>5919 6466</del> at the junction with King's Clipstone Bridleway 4
Finishing Point:	SK5962 6405 at the junction with Clipstone Footpath 24
General Description:	Between SK <del>5919 6466</del> and SK5936 6451, proceeds in a south-easterly direction along a track with a hedgerow to the right-hand side, on a stone and earth surface. <span style="color: red;">There is a field gate at SK 5920 6466.</span> Between SK5936 6451 and SK5962 6405, proceeds in a south-easterly then south-south-easterly direction inside the perimeter of Intake Wood on an earthen surface.
Legal Event / Remarks	The Nottinghamshire County Council (Kings Clipstone Footpath No.11 And Clipstone Footpath No.24) Modification Order 2021

**The Definitive Statement for the Parish of Clipstone shall be amended as follows**

Status and Path No.	Footpath 24
O. S. Sheet No:	SK56SE
Approx. Length:	11 metres
Width:	1.2 metres
Starting Point:	SK5962 6405 at the junction with Kings Clipstone Footpath 11
Finishing Point:	SK5962 6404 at the junction with Cavendish Way
General Description:	Proceeds in a south-south-easterly direction on an earthen surface
Legal Event / Remarks	The Nottinghamshire County Council (Kings Clipstone Footpath No.11 And Clipstone Footpath No.24) Modification Order 2021



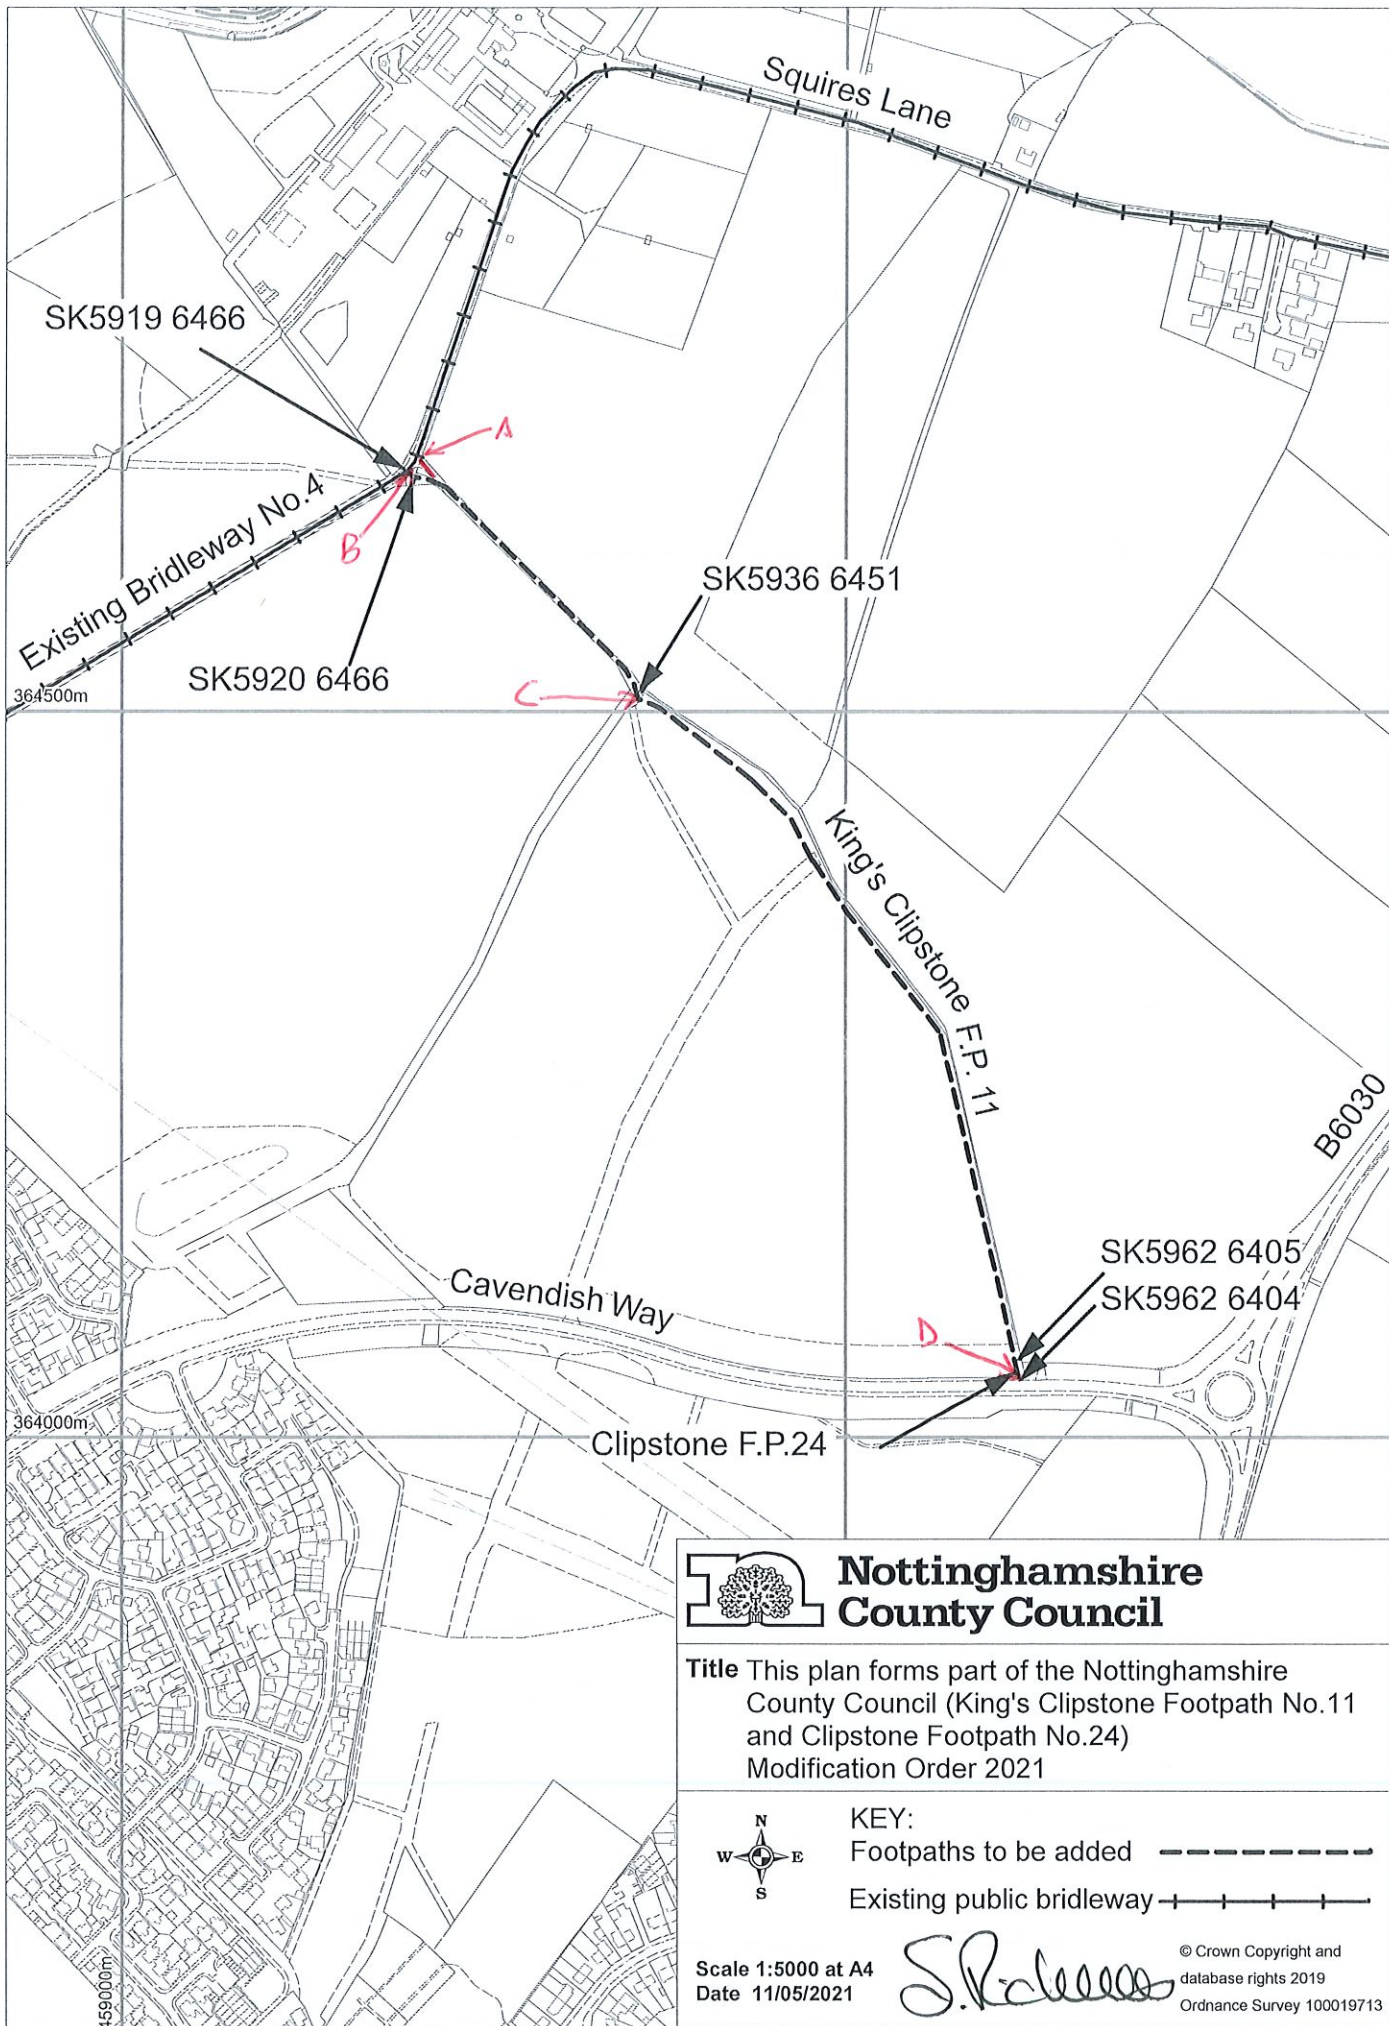

## Nottinghamshire County Council

**Title** This plan forms part of the Nottinghamshire  
County Council (King's Clipstone Footpath No.11  
and Clipstone Footpath No.24)  
Modification Order 2021



### KEY:

Footpaths to be added ————

Existing public bridleway ————

Scale 1:5000 at A4  
Date 11/05/2021

*S. P. Release*

© Crown Copyright and  
database rights 2019  
Ordnance Survey 100019713