CAR PARKING SPACE NUMBERS

Car Park	Patient & Visitor Disabled	Patient & Visitor Pay on Foot	Patient & Visitor Pay & Display	Staff Disabled	Staff Permit
No 1 (P&V PoF)	35	267			
No 1A (P&V PoF)	11	129			
No 1a (P&V P&D)	2		33		
No 2 (P&V PoF)	5	79			
No 3 (Staff, part adhoc)					42
No 4 (P&V P&D)			30		
No 7 (Staff)					79
No 8 (Staff)					640
No 9 (P&V PoF)	9	93			
No 10 (Staff)				7	163
No 11 (Staff, part adhoc))					257
No 14 (Staff)				2	17
No 20 (P&V P&D)	1		154		
No 21 (Staff adhoc)					143
Block 14 (Staff)				4	20
Block 16 (Staff)				9	95
Block 24 (Staff, part adhoc)					39
Block 36 (Staff)				3	18
FM Yard (Staff, part adhoc)					24
Northfield (Staff, part adhoc)					141
Layby south of Block 4 (Disabled)	2				
Layby near Block 11 (Disabled)	3				
Layby near Block 14 (Staff)					4
Layby near Northfield (Staff)					25
TOTALS	68	568	217	25	1707

PARKING EQUIPMENT

Car Park	Equipment
No 1 (P&V PoF)	2 x PoF Ticket Entry Terminal/Barrier 1 x PoF Ticket Exit Terminal/Barrier
No 1A (P&V PoF)	1 x PoF Ticket Entry Terminal/Barrier 1 x PoF Ticket Exit Terminal/Barrier
No 1a (P&V P&D)	1 x P&D Coin Ticket Machine
No 2 (P&V PoF)	1 x PoF Ticket Entry Terminal/Barrier 1 x PoF Ticket Exit Terminal/Barrier
No 3 (Staff, part adhoc)	None
No 4 (P&V P&D)	1 x P&D Coin Ticket Machine
No 7 (Staff)	1 x Fob Entry Terminal/Barrier 1 x Fob Exit Terminal/Barrier
No 8 (Staff)	1 x Fob Entry Terminal/Barrier 1 x Fob Exit Terminal/Barrier
No 9 (P&V PoF)	1 x PoF Ticket Entry Terminal/Barrier 1 x PoF Ticket Exit Terminal/Barrier 1 x PoF Coin/Note Payment Terminal
No 10 (Staff)	1 x Fob Entry Terminal/Barrier 1 x Fob Exit Terminal/Barrier
No 11 (Staff, part adhoc))	1 x Fob Entry Terminal/Barrier 1 x Fob Exit Terminal/Barrier 2 x Barrier (unused)
No 14 (Staff)	2 x Fob Entry/Exit Terminal 1 x Barrier
No 20 (P&V P&D)	2 x P&D Coin Ticket Machine
No 21 (Staff adhoc)	None
Block 14 (Staff)	2 x Fob Entry/Exit Terminal 1 x Barrier
Block 16 (Staff)	1 x Fob Entry Terminal/Barrier 1 x Fob Exit Terminal/Barrier
Block 24 (Staff, part adhoc)	1 x Fob Entry Terminal/Barrier 1 x Fob Exit Terminal/Barrier
Block 36 (Staff)	2 x Fob Entry/Exit Terminal 1 x Barrier
FM Yard (Staff, part adhoc)	Gate
Northfield (Staff, part adhoc)	1 x Barrier (unused)
Layby south of Block 4 (Disabled)	None
Layby near Block 11 (Disabled)	None
Layby near Block 14 (Staff)	None
Layby near Northfield (Staff)	None
Inside Main Entrance	2 x PoF Coin/Note Payment Terminal
Outside Main Entrance	2 x PoF Coin/Note Payment Terminal
Road adjacent Block 18	2 x Fob Terminal 1 x Barrier (unused)

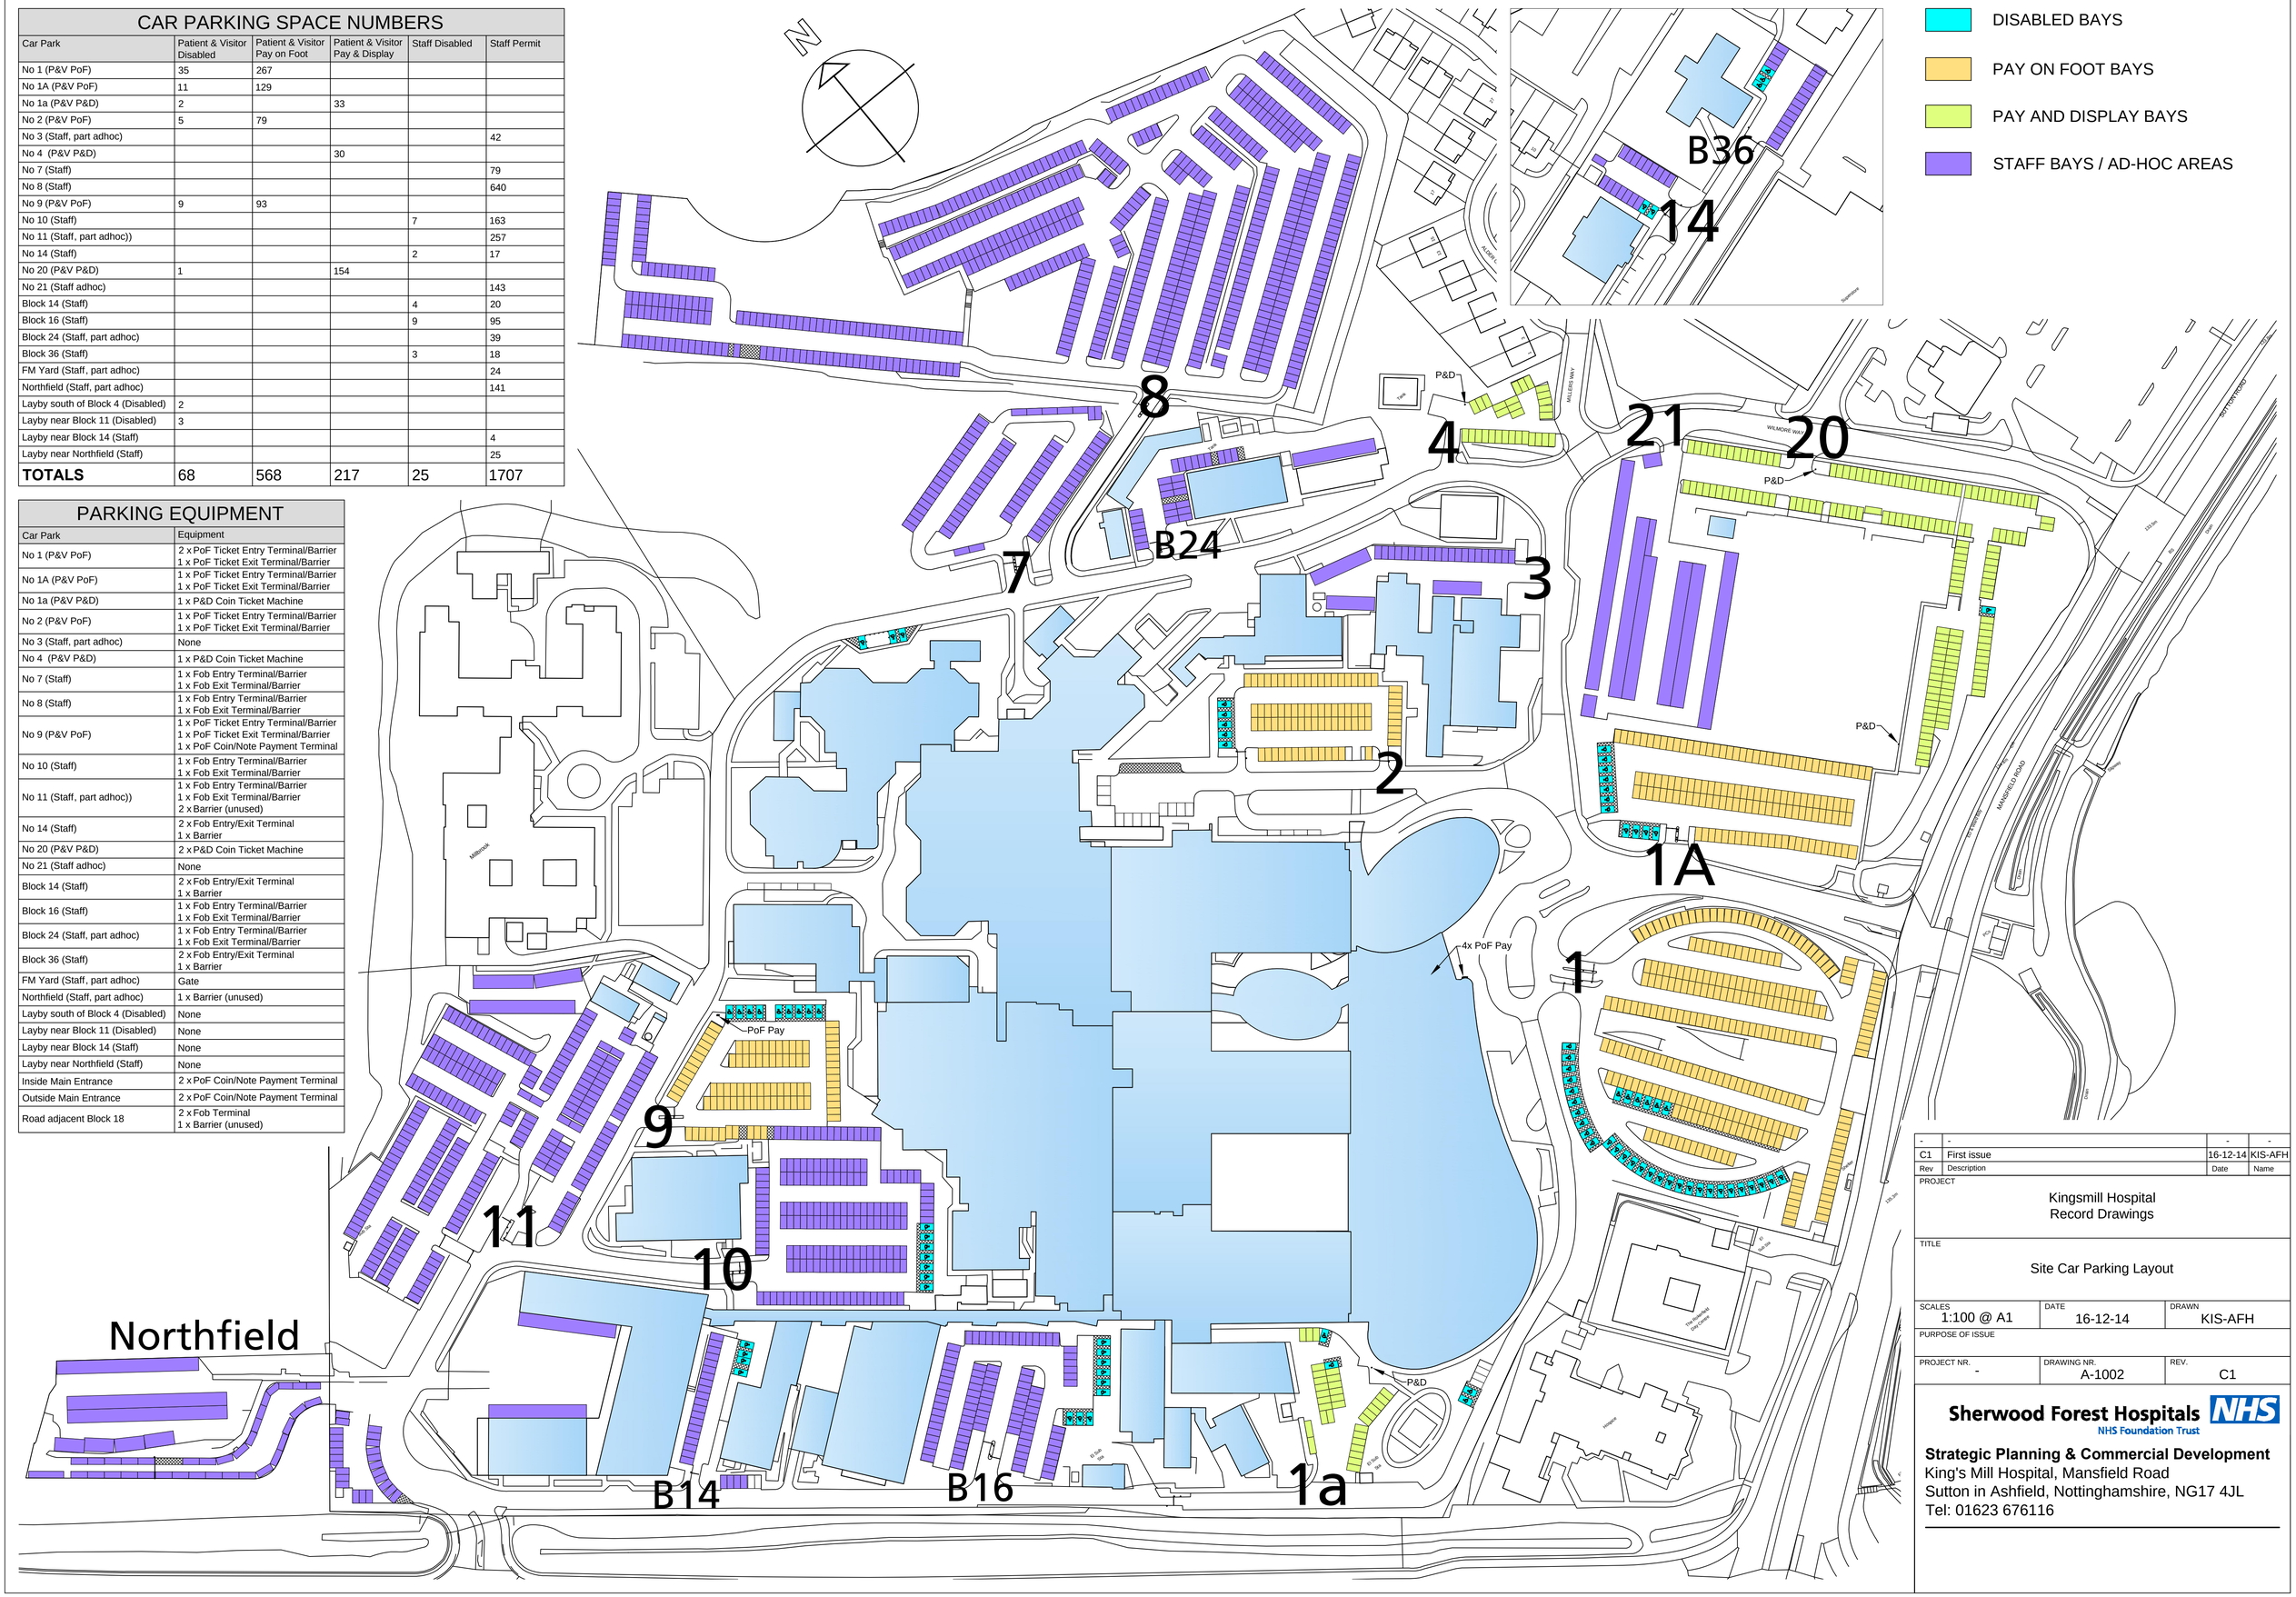

Rev	Description	Date	Name
-	-	-	-
C1	First issue	16-12-14	KIS-AFH

PROJECT
Kingsmill Hospital
Record Drawings

TITLE
Site Car Parking Layout

SCALES	DATE	DRAWN
1:100 @ A1	16-12-14	KIS-AFH

PURPOSE OF ISSUE

PROJECT NR.	DRAWING NR.	REV.
-	A-1002	C1

Sherwood Forest Hospitals NHS
NHS Foundation Trust
Strategic Planning & Commercial Development
King's Mill Hospital, Mansfield Road
Sutton in Ashfield, Nottinghamshire, NG17 4JL
Tel: 01623 676116