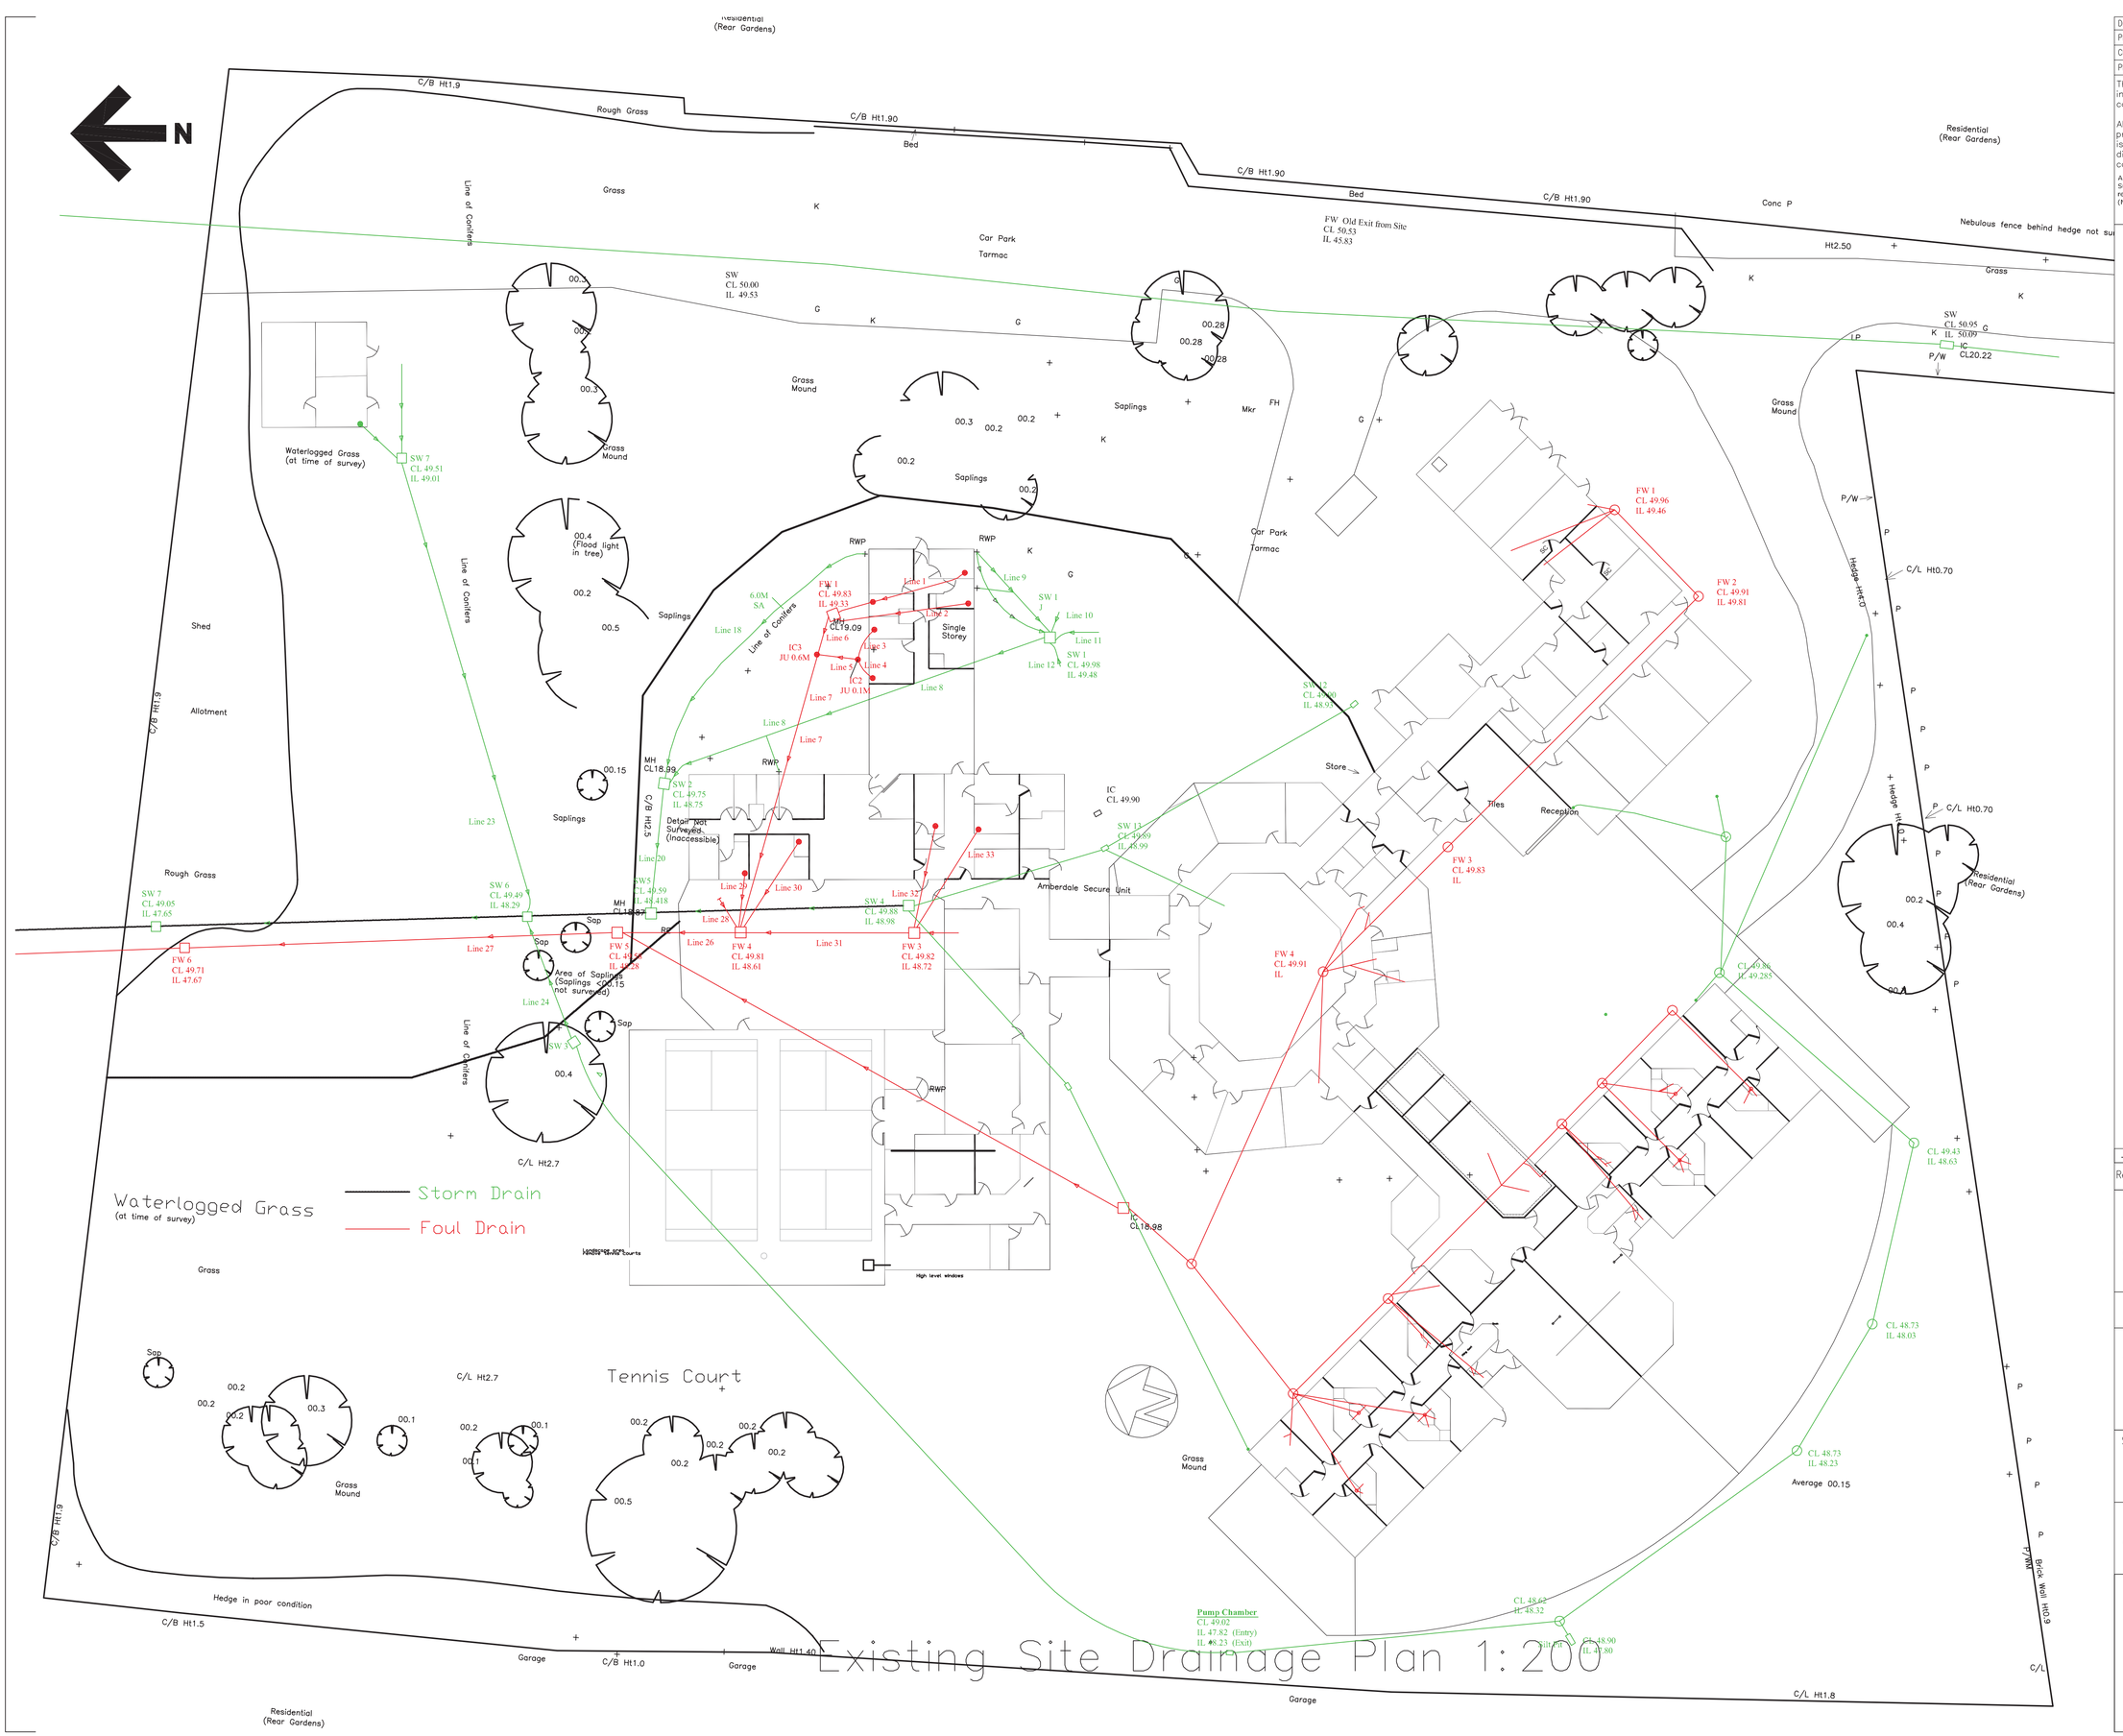


Drawing Status							
Preliminary		Building Control		Measurement		Site	
Client Approval		Fire Precautions		Tender		As Built	
Planning	X	Pre-Tender		Contract			

This drawing should be read in conjunction with all other design information, drawings and documents including all other design consultants requirements including structural, mechanical, electrical.

All dimensions to be verified on site. Figured dimensions to take preference to those scaled. This drawing is Copyright. The drawing is issued on the condition that it is not copied, reproduced, retained or disclosed to any unauthorised person, either wholly or in part without consent in writing.

Any map on a drawing is based upon Ordnance Survey materials with the permission of Ordnance Survey on behalf of the Controller of Her Majesty's Stationery Office © Crown copyright. Unauthorised reproduction infringes Crown copyright and may lead to prosecution or civil proceedings. (Nottinghamshire County Council) (Licence No.100019713)

Rev	Description	Drawn	Ch'kd	Auth	Date
–	–				–

Project
Clayfields House
18-20 Moorbridge Lane
Stapleford
Nottingham, NG9 8GU

Property No.	Project No.
UPRN 06039	**P.Y.RE.00001**

Title
Admin / Entrance Extension
Rear Workshops and Assoc External Works
Existing Site Drainage Plan

Scale for A1 drawing	Drawn	Date
1 to 200 @A1	**SR/JS**	**23.08.2013**
	Ch'kd	Date
	Auth	Traced

Drawing No. **AL(0) 211** Rev.

FileName:

Nottinghamshire County Council
Trent Bridge House, Fox Road,
West Bridgford, Nottingham, NG2 6BJ
Tel: 0300 0500 80 80

© Nottinghamshire County Council